

WATER SERVICE RECORD

Name

Service No.

Address 4 Bowser Road

1691

Location Lot#4 Sta. 7+65 El. 181.18


Repair—Renewal—New Service

Date	Material	Amount	Total	Date	Amount	
6-22-62	Labor	2.13				
	10% C.H.	.21	2.34			
	21' 3/4" Copper tubing @.42		8.82			
	1 hr. Trucking @3.00		3.00			
	BILL WHEN CONNECTED		14.16			
					NOK CHARGE	
				6-22-62	Labor	2.13
					27' 3/4" Copper tubing @.42	11.34
					1 3/4" G Corp Cock	4.91
					1 3/4" G Curb Cock	6.28
					1 Box & Rod	4.90
						29.56

TOWN OF LEXINGTON — BOARD OF PUBLIC WORKS

WATER DIVISION

Sketch of Service Here

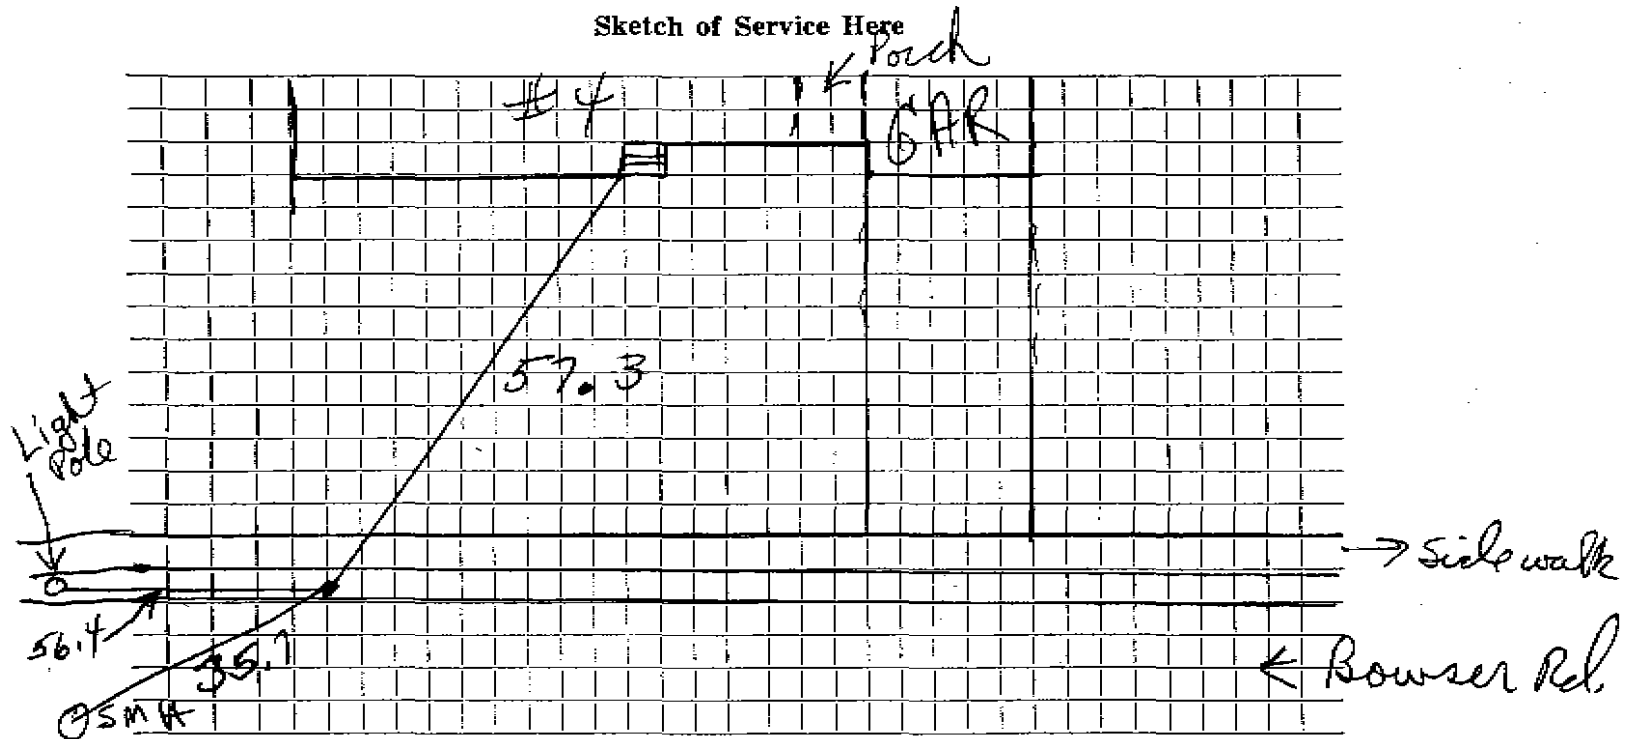

Connection made in Street. Work completed

Remarks:
.....
.....