

WATER SERVICE RECORD

Name Moore Realty Trust

Service No. 154

Address 5 Bowser Road

Location Lot #21 Sta. 6+36 El. 181.58

~~Repair~~ ~~Repair~~ - New Service WOT # 7704

Comm 1-14-63


Date	Material	Amount	Total	Date	Material	Amount
6-22-62	Labor	2.13		11-1-62	Deposit	50.00
	10% O.H.	.21	2.34	1-14-63	Paid by SHC #129	11.53
	21' 3/4" Copper tubing @.42		8.82			61.53
	1 hr. Trucking @3.00		3.00			
	BILL WHEN CONNECTED		14.16		NON CHARGE	
11-14-62	Labor	4.44		6-22-62	Labor	2.13
	10% O.H.	.44	4.88	11'	3/4" Copper tubing @.42	4.62
	75' 3/4" Copper tubing @.42		31.50	1	3/4" C Curb Cock	6.28
	1 3/4" CX 1/2 I.W.H. Stop & Waste		6.17	1	3/4" C Corp Cock	4.91
	2 3/4" C3 Part Unions @2.41		4.82	1	Box & Rod	4.90
			61.53			22.84
				11-14-62		
					1 1/2 Straight Tailpiece	.50
					1 1/2 Offset Tailpiece	.50
						23.84

DATE _____

TOWN OF LEXINGTON — BOARD OF PUBLIC WORKS

WATER DIVISION

Sketch of Service Here

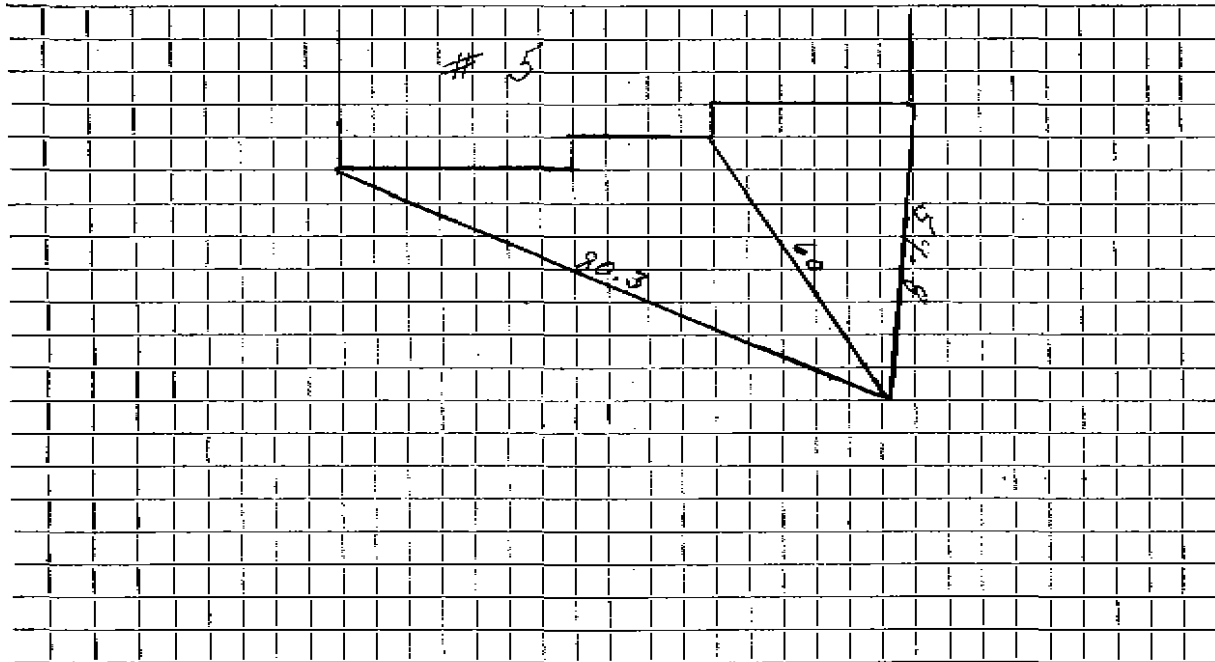

Connection made in Street. Work completed

Remarks:

.....

.....