

WATER SERVICE RECORD

Name Moore Realty Trust

Service No. 1

Address 6 Bowser Road

#7104

Location Lot #32 Sta. 5+78 El. 181.78

Repair—Renewal—New Service W.O.# 8460

MAR 23 1964


Date	Material	Amount	Total	Date	Material	Amount
6-22-62	Labor	2.13		1-3-64	Deposit	50.00
	10% O.H.	.21	2.34	3-23-64	Paid by W.O.# 131	7.63
10'	3/4" Copper tubing @.42		4.20			57.63
1	hr. Trucking @3.00		3.00			
	BILL WHEN CONNECTED		9.54		NON CHARGE	
1-6-64	Labor	2.42		6-22-62	Labor	2.13
	10% O.H.	.24	2.66	27'	3/4" Copper tubing @.42	11.34
82'	3/4" Copper Tubing @.42		34.44	1	3/4" C Corp Cock	4.91
1	3/4" CX 1/2 I.W.E. Stop & Waste		6.17	1	3/4" C Curb Cock	6.28
2	3/4" C3 Part Unions @2.41		4.82	1	Box & Rod	4.90
			57.63			29.56
				1-6-64	1 1/2 Straight Tailpiece	.50
					1 1/2 Offset Tailpiece	.50
						30.56

DATE _____

TOWN OF LEXINGTON — BOARD OF PUBLIC WORKS

WATER DIVISION

Sketch of Service Here

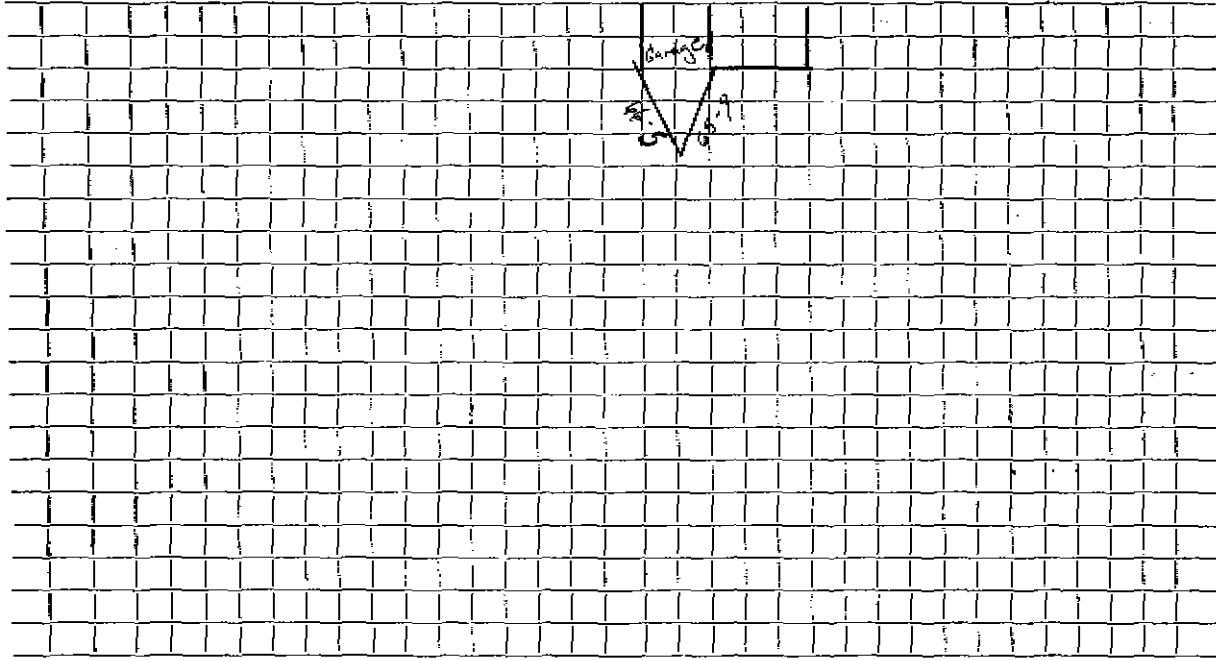

Connection made in Street. Work completed

Remarks:
.....
.....