

WATER SERVICE RECORD

Name Chester R. Banks

Service No. 74

Address 8 Bowser Road

Location Lot #31 Sta. 3+91 El. 181.93

~~STOPX-BANKS~~ - New Service

wo # 8096

Comm 10-28-63

Date	Material	Amount	Total	Date	Amount	
6-22-62	Labor	2.13		8-7-63	Deposit	100.00
	10% O.H.	.21	2.34	10-28-63	Refund	25.51
	16' 3/4" Copper tubing @.42		6.72			74.49
	1 hr. Trucking @3.00		3.00			
	BILL WHEN CONNECTED		12.06		NON CHARGE	
8-14-63	Labor	11.73		6-22-62	Labor	2.13
	10% O.H.	1.17	12.90	25'	3/4" Copper tubing @.42	10.50
	75' 3/4" Copper Tubing @.42		31.50	1	3/4" C Corp Cock	4.91
	1 3/4" CX 1/2 I.W.H. Stop&Waste		6.17	1	3/4" C Curb Cock	6.28
	2 3/4" C3 Part Unions @2.41		4.82	1	Box & Rod	4.90
	1 Hr. Town Shovel @6.50		6.50			28.72
			74.49			


DATE _____

TOWN OF LEXINGTON — BOARD OF PUBLIC WORKS

WATER DIVISION



Sketch of Service Here

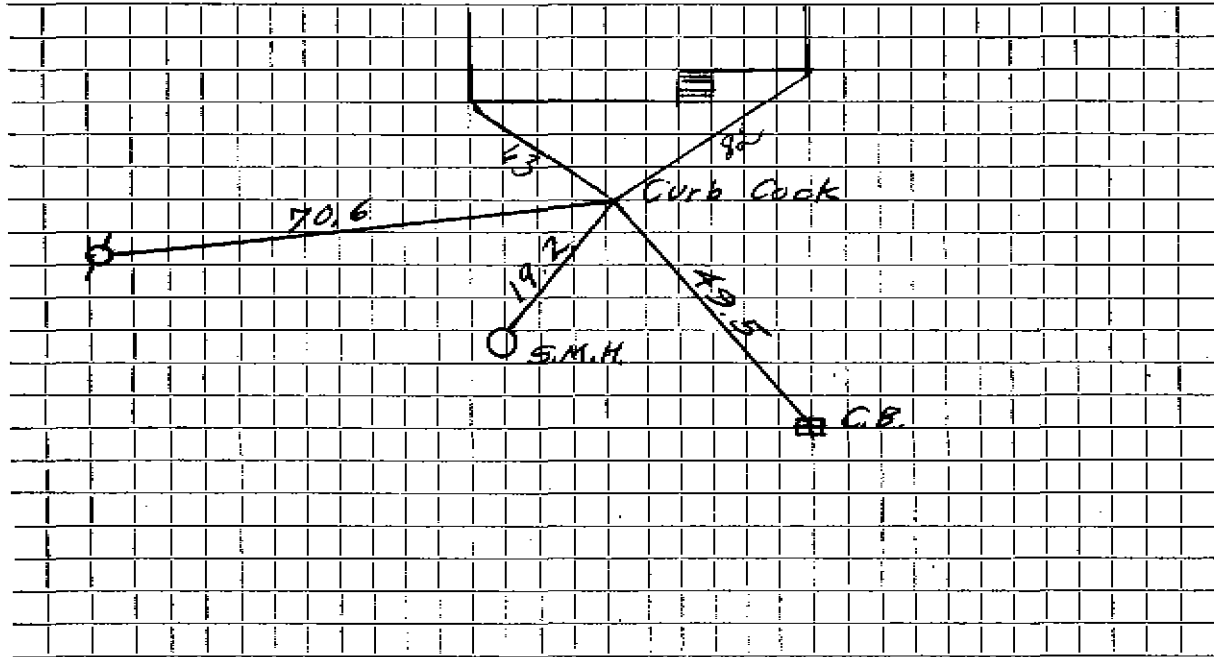

Connection made in Street. Work completed

Remarks:

.....

.....