

WATER SERVICE RECORD

#5630
#6439
63

Name Robert Johnson

Service No.

Address 9 Bowser Road

Location Lot #19 Sta. 2+76

Repair—Renewal—New Service

WO# 8039

Comm 10-28-63


Date	Material	Amount	Total	Date	Amount
6-27-63	Labor	18 36		6-21-63	Deposit 40 00
	10% O.H.	1 84	20 20	11-8-63	Paid 20 76
69	3/4" Copper Tubing @.42		28 98		60 76
	1 3/4" CX# I.W.E. Stop & Waste		6.17		
	1 3/4" G3 Part Union		2.11		NON CHARGE
	1 Hr. Trucking @3.00		3 00	6-22-62	Labor 2.13
			60 76		9' 3/4" Copper tubing @.42 3.78
					1 3/4" C Curb Cock 6.28
					1 3/4" C Corp Cock 4.91
					1 Box & Rod 4.90
					22.00
				6-27-63	1 1/2 Straight Tailpiece 50
					1 1/2 Offset Tailpiece 50
					23 00
					PAID 30.76

DATE _____

TOWN OF LEXINGTON — BOARD OF PUBLIC WORKS

WATER DIVISION

Sketch of Service Here

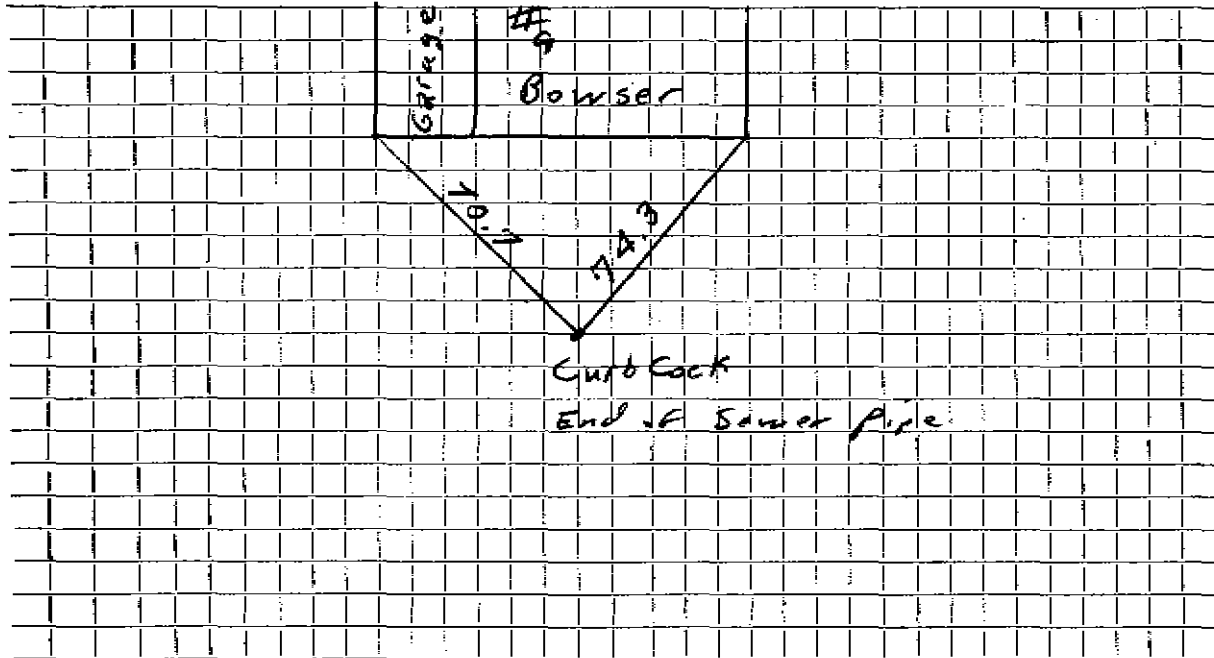

Connection made in Street. Work completed

Remarks:

.....

.....