


DATE _____

TOWN OF LEXINGTON — BOARD OF PUBLIC WORKS

WATER DIVISION

Sketch of Service Here
LOT 16

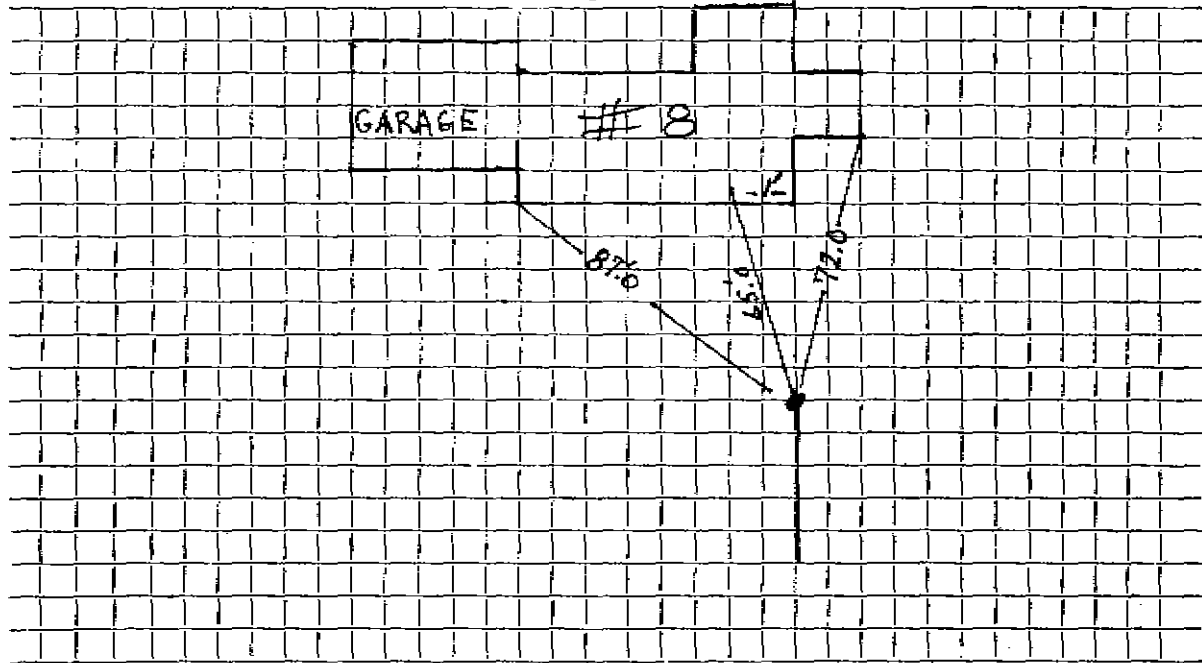

Connection made in Boxwood B.D. Street. Work completed

Remarks: