

Name E. B. Hamilton

Service No.

Address 1 Braemore Terrace

Lexington, Mass.

Location 1 Braemore Terrace

Kind of Pipe

Size

Size of Main

~~Repair~~ ~~Renewal~~ ~~XXXXXX~~ ~~XXXXXX~~ ~~XXXXXX~~ New Service

Location

Date	Material	Amount	Total	Date		Amount
June 5, '47	Labor	29 00	29 00	May 22 '47	Disputed Paid	50 00
	10% Overhead		22 90	Sept 23 '47		
	60' - 3/4" Copper Tubing @ .27		16 20		Non-Charge	52 00
	1 - 3/4" x 1/2" I.W.H. S&W		3 15	June 5, '47	Labor	48 98
	Trucking 1 hr. @ .75		75	35' - 3/4" Copper Tubing @ .27		9 45
			52 00	1 - 3/4" C Corp-cock		3 00
				1 - 3/4" C x 3/4" C Curb-cock		3 68
				1 - Box & Rod		4 26
				Dynamite 3 lbs. @ .21		63
				Exploders 3 @ .11		33
				1 - 1/2" Offset Tail Piece		30
				1 - 1/2" Straight Tail Piece		30
	Labor			Compressor 3 hrs. @ 1.75		5 25
				Trucking 1 hr. @ .75		75
				5/31/62 1 88 Unions		
				1 Curb		
				1' 3/4 COPPER		

TOWN OF LEXINGTON - BOARD OF PUBLIC WORKS

WATER DIVISION

The undersigned applies for a supply of water at No..... St. and hereby agrees to comply with the rules and regulations as now, or at any future time, established by the Board of Selectmen.

Am't of Estimate \$.....

Owner


Am't Paid \$.....

Address

Builder

.....

Sketch of Service Here

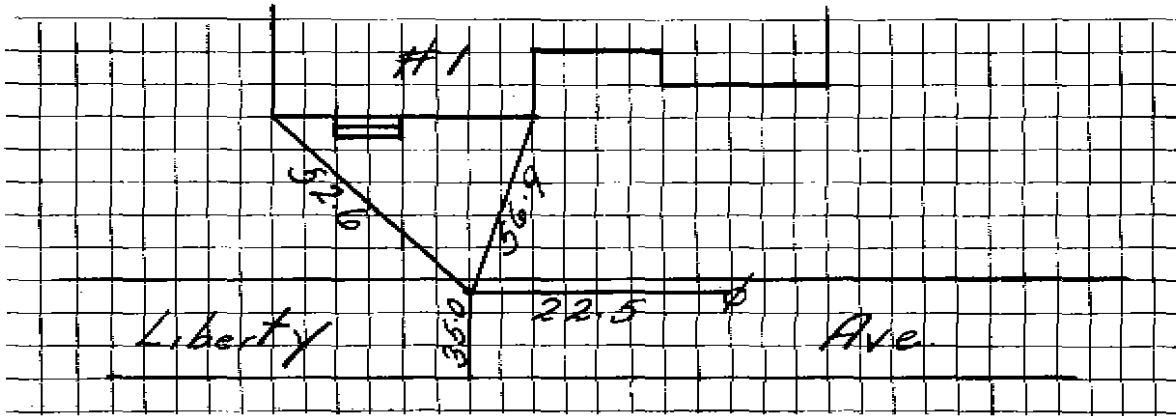

Connection made in Street.

Work completed19

Remarks: