

WATER SERVICE RECORD

5520

Name Donald B. Banks

Service No. 166

Address 11 Brandon Street

Location

~~REPAIR WORK~~ New Service


Comm 11-16-59

Date	Material	Amount	Total	Date	Material	Amount
8-11-59	Labor	1.85		7-27-59	Deposit	35.00
	10% O.H.	.19	2.04	11-16-59	Retard	12.02
35'	3/4" Copper tubing@.41		14.35			22.98
1	3/9" Cx 1/2 L.W.H. Stop&Waste		5.84			
1	Hr. Trucking@.75		.75		NON-CHARGE	
			22.98		Labor	1.69
				20'	3/4" Copper tubing@.41	8.20
				1	3/4" C3 Part Union	2.30
				1	3/4" C Curb Cock	5.94
				1	2"x1" LL Tee @	2.91
				1	Box&Rod	5.00
				2	2x6 C.L. Nipples@.79	1.58
				2	2" Style 38 Clamps	2.60
				1	1/2 Straight tailpiece	.50
				1	1/2 Offset tailpiece	.50
						31.22

DATE _____

TOWN OF LEXINGTON — BOARD OF PUBLIC WORKS
WATER DIVISION

Sketch of Service Here

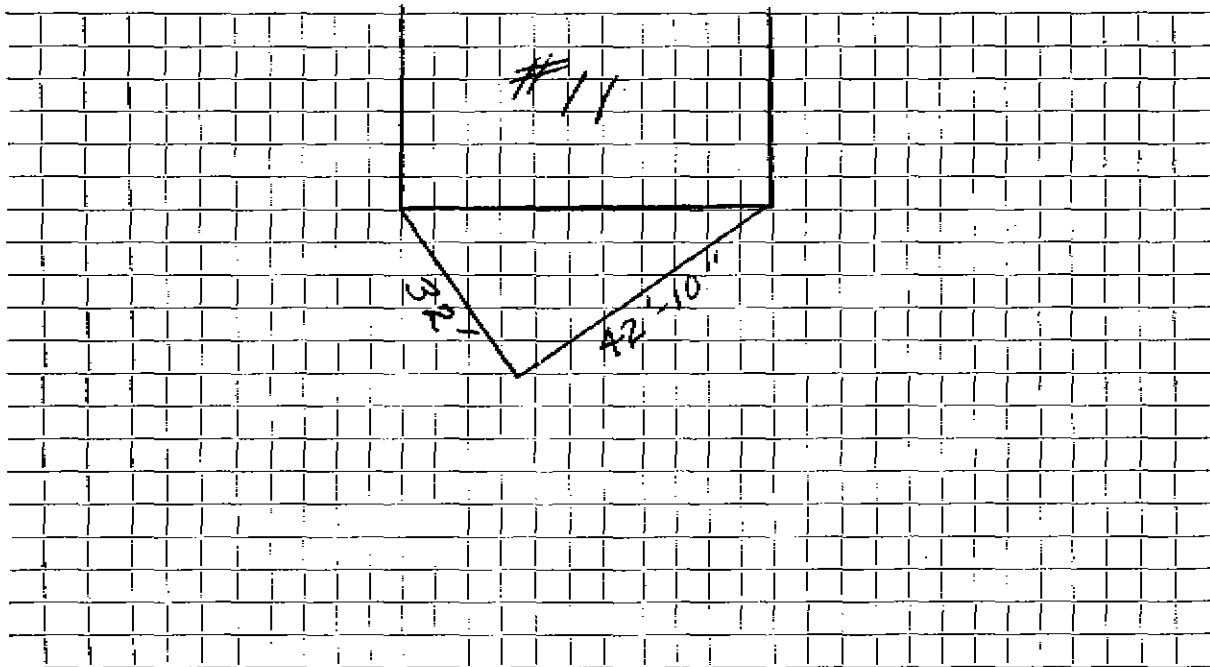

Connection made in Street. Work completed

Remarks:
.....
.....