

Name John B. Hughes
 Address 12 Brandon Street
 Lexington, Mass.

Service No. 101

Location 12 Brandon Street

Kind of Pipe

Size

Size of Main

~~Repair~~ ~~Renewal~~ New Service

Location

Date	Material	Amount	Total	Date	Amount
Aug. 28, '48	Labor	1 25	1 25	Aug 17 48	15 00
	10% Overhead		13	Dec 31 48	1 81
	31' - 3/4" Copper Tubing @.255	7 91	7 91		13 19
	1 - 3/4" C x 1/2" I.W.H. S&W	3 15	3 15	Aug. 26, '48	12 75
	Trucking 1 hr. @.75		75	27	8 50
			13 19	28	22 78
				18' - 3/4" Copper Tubing @.255	4 59
				1 - 3/4" C x 3/4" C Curb-cock	3 68
				1 - 2" C.L. Nipples 6" long	60
				1 - 2" x 1 1/4" L.L.Tee	
				1 - 1 1/4" x 1" Bushing	20
				1 - 1" I x 3.4" C Union (2pts)	1 77
	Labor			2 - 2" Repair Clamps	2 46
				1 - Box & Rod	3 55
				1 - 1/2" Offset & Straight Tail Piece	60
				Trucking 1 hr. @.75	75

DATE _____

TOWN OF LEXINGTON – BOARD OF PUBLIC WORKS

WATER DIVISION

The undersigned applies for a supply of water at No..... St. and hereby agrees to comply with the rules and regulations as now, or at any future time, established by the Board of Selectmen.

Am't of Estimate \$.....

Owner


Am't Paid \$.....

Address

Builder

.....

Sketch of Service Here

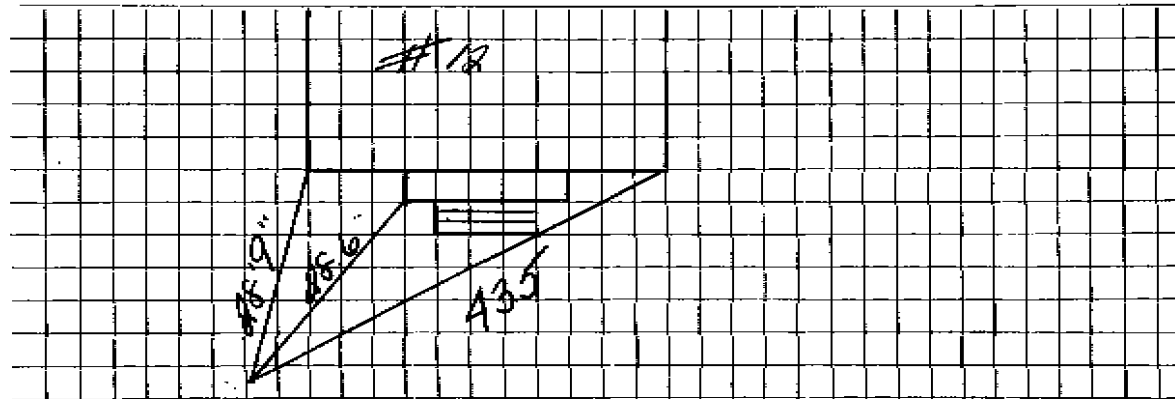

Connection made in Street.

Work completed19

Remarks: