

Name Frank G. Poitras

Service No. ~~15~~ 385

Address ~~Wilmington, Mass.~~ 15 Brandon St.

#15 Brandon St

Location cor Fottler Ave. & Brandon St. # 2093

Kind of Pipe

Size

Size of Main

Repair—Renewal—New Service

Location

Date
1938

Material

Amount

Total

Date

Amount

5/12/38

2 hrs. @ 60¢

1 20

May 3, 1938 Deposited

17 50

41' 3/4" C. Tubing @ 20¢

8 20

1 3/4" S. & W.

3 75

2 3/4" C. Unions

2 20

15 35

Flat Rate:

\$17 50

Labor

DATE April 5, 1938

TOWN OF LEXINGTON—BOARD OF PUBLIC WORKS

WATER DIVISION

Car Feller + Brandon St.

Lots 128 + 129 (#15 Brandon St.)

The undersigned applies for a supply of water at No. _____ St. and hereby agrees to comply with the rules and regulations as now, or at any future time, established by the Board of Selectmen.

Am't. of Estimate \$ _____

Owner


Frank G. Poitast
Box Marjorie M. Poitast
Wilmington
Mass.

Am't. Paid \$ _____

Address

Builder _____

Sketch of Service Here

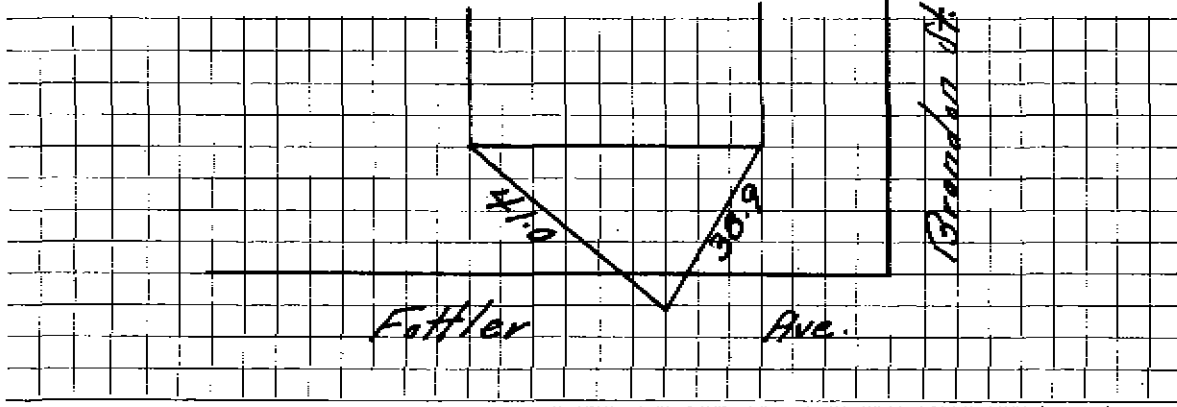

Connection made in _____ Street.

Work completed _____ 19

Remarks: