

Name Donald Banks

2273

Service No. 157

Address 16 Brandon Street

Lexington, Mass.

Location 16 Brandon Street

Kind of Pipe

Size

Size of Main

~~Repair~~ ~~Renewal~~ New Service

Location

Date

Material

Amount

Total

Date

Amount

Date	Material	Amount	Total	Date	Location	Amount
Aug. 24, '48	Labor	2 10	2 10	Aug 10 '48	Deported	15 00
	10% Overhead		21			
	36' - 3/4" Copper Tubing @ .255	9 18	9 18		Non-Charge	
	1 - 3/4" O x 3/8" I.W.N. @ .75	3 15	3 15	Aug. 24, '48	Labor	2 10
	Trucking 1 hr. @ .75	75	75		16' - 3/4" Copper Tubing @ .255	4 08
			15 39		1 - 3/4" O Corp-cock	3 00
					1 - 3/4" O x 3/8" O Barb-cock	3 68
					1 - Box & Rod	3 55
	trench dug by owner.				1 - 1/2" Straight Tail Piece	30
					1 - 3" Offset Tail Piece	30
					Trucking 1 hr. @ .75	75
	Labor					17 76

DATE _____

TOWN OF LEXINGTON—BOARD OF PUBLIC WORKS

WATER DIVISION

The undersigned applies for a supply of water at No. _____ St. and hereby agrees to comply with the rules and regulations as now, or at any future time, established by the Board of Selectmen.

Am't. of Estimate \$ _____


Owner _____

Am't. Paid \$ _____

Address _____

Builder _____

Sketch of Service Here

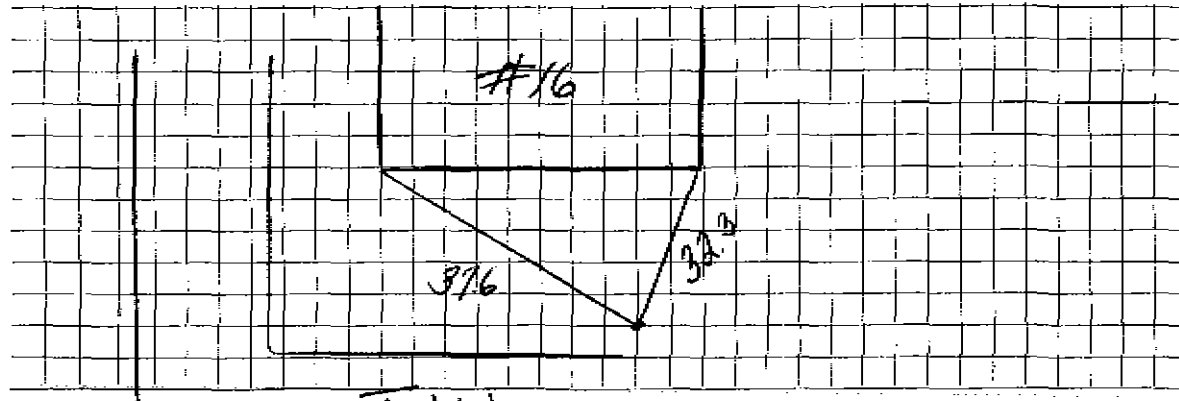

Connection made in Tottler Street.

Work completed _____ 19

Remarks: