

WATER SERVICE RECORD

#2013
9091

Name J. Neil Morrissey

Service No. 133

Address 25 Brandon Street

Location

Repair ~~Remove~~ - New Service

Com. P-30-54


Date	Material	Amount	Total	Date	Amount
6/28/54	Labor	1 85		6-11-54 Deposited	25 00
	10% Overhead	19	2 04	8-30-54 Refunded	(4 21)
	10'-3/4" Copper Tubing @.35		14 00	NON CHARGE	20 79
	1-3/4" C x 1/2 I.W.F. stop & waste		4 00	6/28/54 Labor	1 85
	1 hr. Trucking		75	12'-3/4" Copper Tubing @.35	4 20
			20 79	1-3/4" C. Corp. cock	4 33
				1-3/4" C x 3/4" C. Curb-cock	4 67
	<u>WATER CHANGE TO NEW MAIN</u>			1 Box & Rod	3 90
9-21-64	1 3/4" Corp. Cock			1-1/8 Straight Tail Piece	50
				1-1/8 offset Tail Piece	50
				1 hr. Trucking	75
					20 70

DATE _____

TOWN OF LEXINGTON - BOARD OF PUBLIC WORKS

WATER DIVISION

Sketch of Service Here

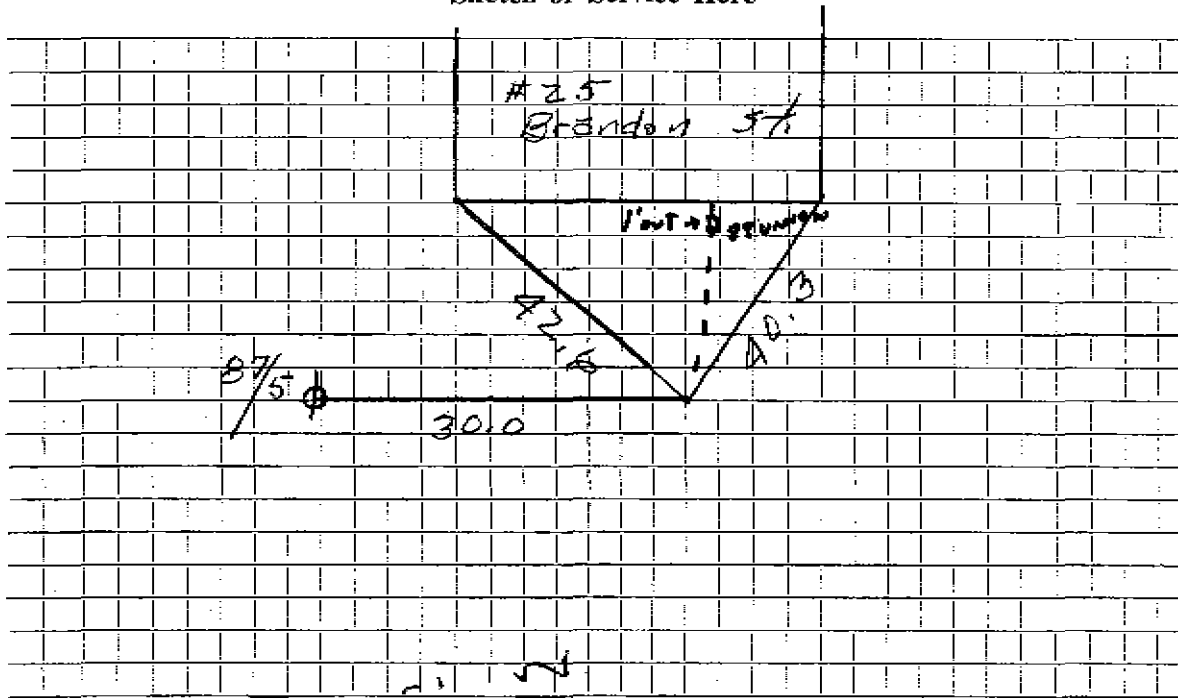

Connection made in 4th Street. Work completed _____

Remarks: _____

