

#6577

WATER SERVICE RECORD

Name Benjamin Gott

Service No. 1924

Address 26 Brandon Street

Location Lexington

~~Repair~~ New Service

Com. 11-3-52


Date	Material	Amount	Total	Date	Amount
9/22/52	Labor	1 63		8-29-52 Deposited	25 00
	10% Overhead	16	1 79	11-5-52 Refunded	(4 86)
	40' - 3/4" Copper tubing @ .34	13 60		NON CHARGE	20 14
	1 - 3/4" C x 1/2 I.W.H. stop & waste	4 00	9/22/52	Labor	1 63
	1 hr. trucking		75	22' - 3/4" Copper tubing @ .34	7 48
			20 14	1 - 3/4" C x 3/4" C. union 3 pts.	1 72
9-21-64	<u>WATER CHANGE TO NEW MAIN</u>			1 - 3/4" C x 3/4" C. curb-cock	4 67
	1 3/4" Corp Cock			1 box and rod	3 90
	1 3/4" Union			1 - 1/2 offset tail piece	50
	5 3/4" Copper tubing			1 - 1/2 straight tail piece	50
				1 hr. trucking	75
					2 16

DATE _____

TOWN OF LEXINGTON — BOARD OF PUBLIC WORKS

WATER DIVISION

Sketch of Service Here

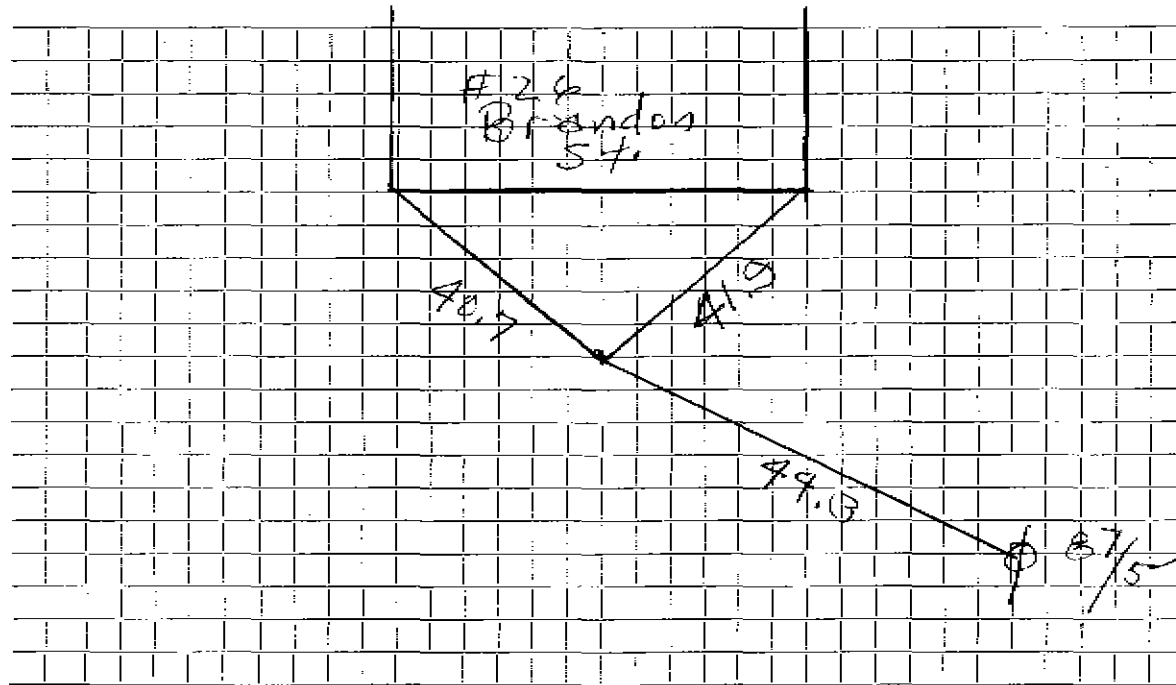

Connection made in Street. Work completed

Remarks:

.....

.....