

WATER SERVICE RECORD

Name E. Spagnuolo

Service No. 51

Address 29 Brandon Street

Location

~~Repair~~ ~~Renewal~~ New Service

*Com. 5-3-54*

| Date    | Material                         | Amount | Total | Date                                | Amount |
|---------|----------------------------------|--------|-------|-------------------------------------|--------|
| 3/31/54 | Labor                            | 1 75   |       | 3-25-54 Deposited                   | 25 00  |
|         | 10% overhead                     | 18     | 1 93  | 5-3-54 Refunded                     | 5 02   |
|         | 38'-3/4" Copper tubing @.35      |        | 13 30 | NON CHARGE                          | 19 98  |
|         | 1-3/4 Cx 1/2 I.W.H. stop & waste |        | 4 00  | 3/31/54 Labor                       | 1 75   |
|         | 1 hr. trucking                   |        | 75    | 17'-3/4" Copper tubing @.35         | 5 95   |
|         |                                  |        | 19 98 | 2-3/4" Cx 3/4" S. Globe cock @ 4.57 | 9 34   |
|         | <u>WATER CHANGE TO NEW MAIN</u>  |        |       | 1- Box & rod                        | 3 90   |
| 9-21-64 | 1 3/4" Corp Cock                 |        |       | 1-1/2 Offset tail piece             | 50     |
|         |                                  |        |       | 1-1/2 Straight tail piece           | 50     |
| 2/27/74 | Labor                            | 42 07  |       | 1 hr trucking                       | 75     |
|         | 10% Overhead                     | 4 27   | 46 97 |                                     | 22 69  |
|         | 1 3/4" Style 88 Union            |        | 4 26  | 2/27/74 deposited                   | 75 00  |
|         | 1 Hr. trucking                   |        | 3 00  | 2/10/75 refund                      | 20 72  |
|         |                                  |        | 54 23 |                                     | 54 23  |

*Com. 2/10/75*


work order # 1811

DATE \_\_\_\_\_

TOWN OF LEXINGTON — BOARD OF PUBLIC WORKS

**WATER DIVISION**

Sketch of Service Here

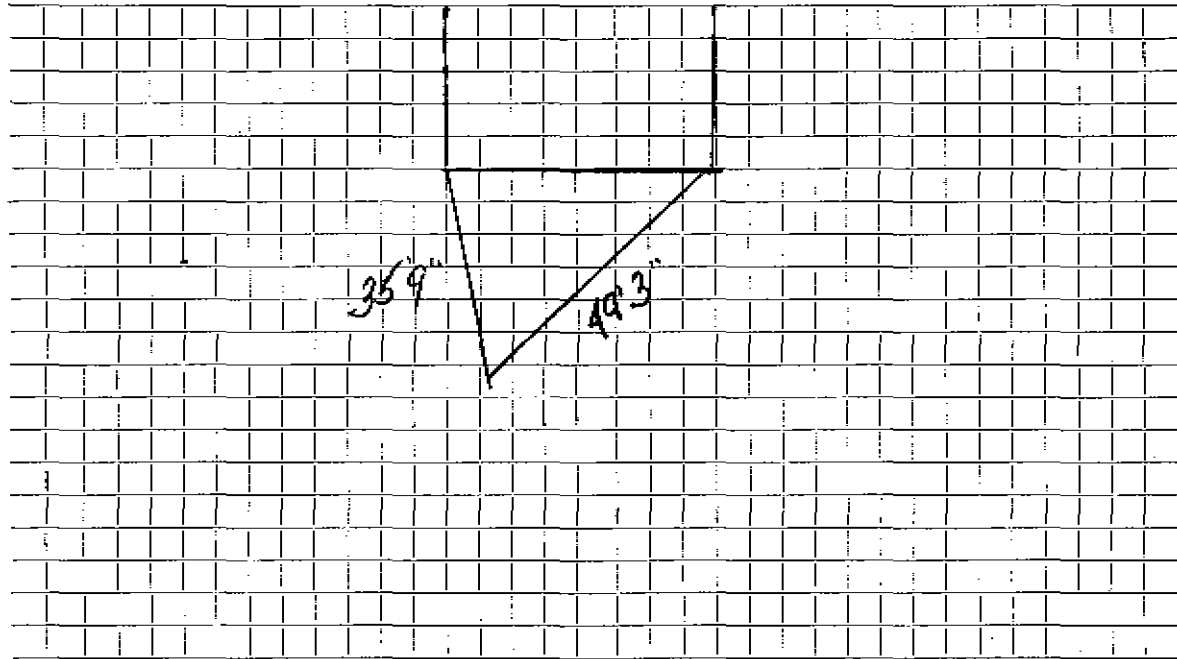

Connection made in ..... Street. Work completed .....

Remarks: .....  
.....  
.....