

WATER SERVICE RECORD

Name Benjamin Gott

Service No. 76 ~~2616~~ 2616

Address 30 Brandon Street

Location Lexington

Repair—Renewal—New Service

Com. 7-28-52


Date	Material	Amount	Total	Date	Amount
6/5/52	Labor	1 63		5-1-52 7-28-52	25 00 4 02
	10% Overhead	16	1 79		NON CHARGE
	42' - 3/4" Copper tubing @ .3439	14 44	6/5/52	Labor	1 63
	1-3/4" C x 1/2 I.W.H. Stop & Waste	4 00	20' - 3/4" Copper tubing @ .3439		6 88
	1 hr. trucking		1 - 3/4" C x 3/4" C. Union 3 pts.		1 72
			20 98	1 - 3/4" C x 3/4" C. Curb-cock	4 67
	<u>WATER CHARGE TO NEW MAIN</u>			1 Box and Rod	4 52
9-21-64	1 3/4" Corp Cock			1-1/2 straight tail piece	50
	1 3/4" Union			1-1/2 offset tail piece	50
	5 3/4" Copper tubing			1 hr. trucking	75
					21 17

DATE _____

TOWN OF LEXINGTON — BOARD OF PUBLIC WORKS

WATER DIVISION

Sketch of Service Here

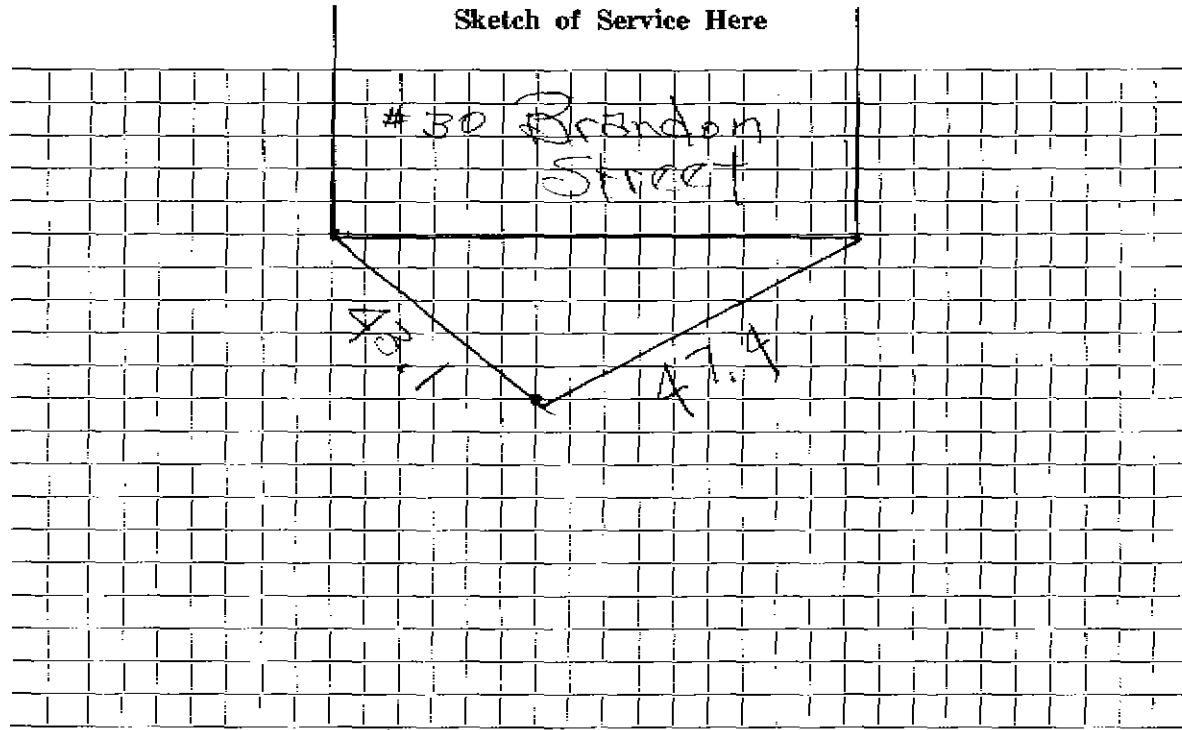

Connection made in Street. Work completed

Remarks:
.....
.....