

WATER SERVICE RECORD

2330

Service No.

52

Name E. Spagnuolo

Address 31 Brandon Street

Location

~~Repair~~ ~~Renewal~~ - New Service


Com. 5-3-54

Date	Material	Amount	Total	Date	Amount
4/1/54	Labor	1 75		3-25-54	Deposited 25 00
	10% overhead	18	1 93	5-3-54	Refunded 1 92
	10'-3/4" Copper tubing @.35		14 00		NQN CHARGE 20 68
	1-3/4" Cx 1/2" I.W.H. Stop & waste		4 00	4/1/54	Labor 1 75
	1 hr trucking		75	17'-3/4" Copper tubing @.35	5 95
			20 68	2-3/4 Cx 3/4" curb cock @ 4.67	9 34
				1-2" x 1" L.L.Tee	2 13
	WATER CHANGE TO NEW MAIN			2-2" Repair clamp @2.62	5 24
9-22-64	1 3/4" Corp Cock			1- Box & rod	3 90
	4' 3/4" Copper tubing			1-1/2 Offset tail piece	50
				1-1/2 Straight tail piece	50
				1 hr trucking	75
					30 06

DATE _____

TOWN OF LEXINGTON — BOARD OF PUBLIC WORKS

WATER DIVISION

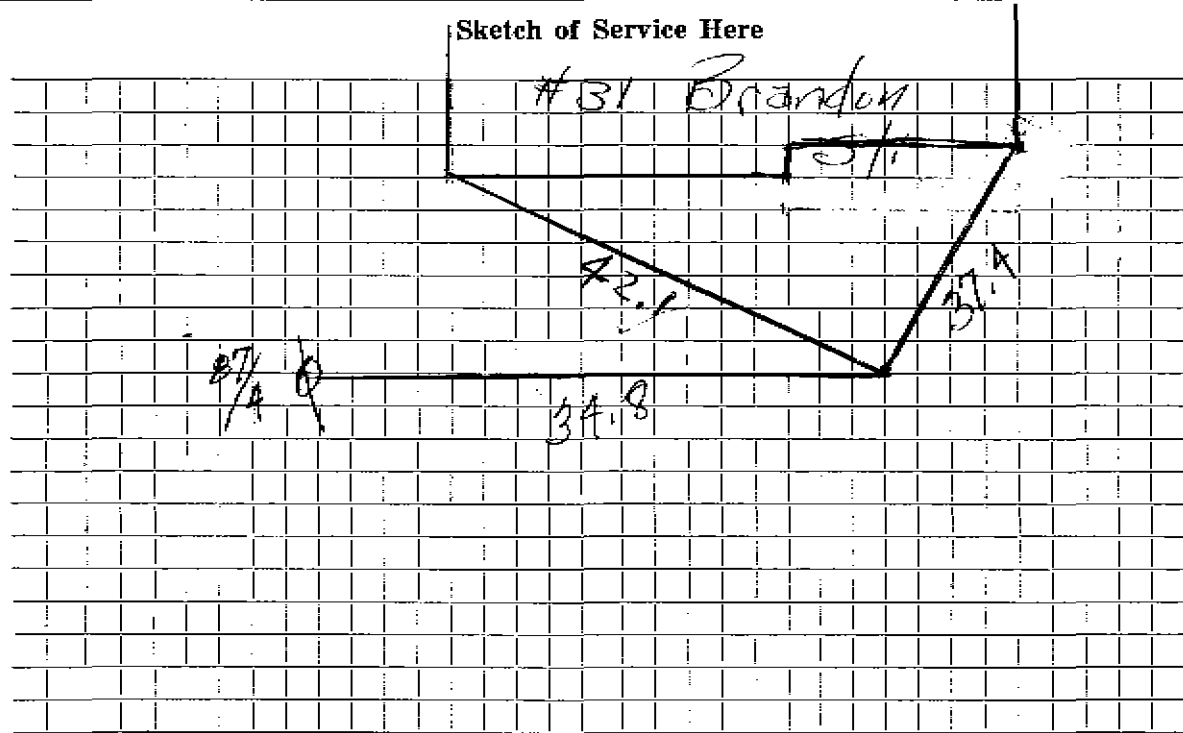

Connection made in Street. Work completed

Remarks:

.....

.....