

WATER SERVICE RECORD

Name Benjamin Gott

Service No. 76

Address 36 Brandon Street

5920

Location Lexington

~~REPAIR WORK~~ New Service

P.m. 7-28-52


Date	Material	Amount	Total	Date	Amount
6/5/52	Labor	1 63		5-1-52 7-28-52	25 00 9 33 21 67
	10% overhead	16	1 79		
	44' - 3/4" copper tubing @ .3439	15 13			
	1 - 3/4" C x 1/2 I.W.H. stop & waste	4 00			<u>NON CHARGE</u>
	1 hr. trucking		75	6/5/52	Labor 1 63
			21 67		26' - 3/4" copper tubing @ .3439 8 94
					1 - 3/4" C x 3/4" C. union 3 pts. 1 72
					1 - 3/4" C x 3/4" C. curb-cock 4 67
	<u>WATER CHANGE TO NEW MAIN</u>				1 box and rod 4 52
9-22-64	1 3/4" Corp Cock				1 - 1/2 offset tail piece 50
	1 3/4" Union				1 - 1/2 straight tail piece 50
	2' 3/4" Copper tubing				1 hr. trucking 75
					<u>23 23</u>

DATE _____

TOWN OF LEXINGTON — BOARD OF PUBLIC WORKS

WATER DIVISION

Sketch of Service Here

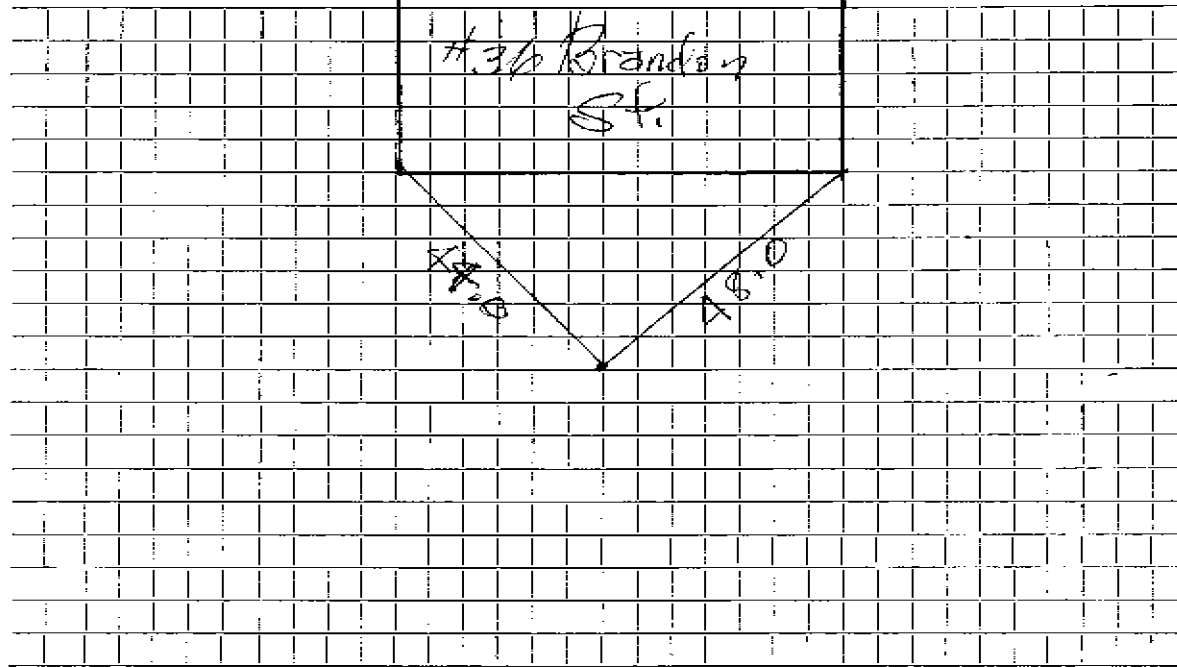

Connection made in Street. Work completed

Remarks:

.....

.....