

WATER SERVICE RECORD

#168

Name J. Edward Gilbert

Service No. 36

Address 37 Brandon Street

#233

Location

Repair—Renewal—New Service

W.O. #6761

SEP 22 1964


Date	Material	Amount	Total	Date	Amount	
8-25-69	Labor	26.98		8-19-64	Deposit	150.00
	10% O.H.	2.70	29.68	9-22-69	Retund	62.07
35'	3/4" Copper tubing @.79		27.65			87.93
1	3/4" Wheel Valve		9.30		CURB TO MAIN	
1/2	yd. Loam @3.50		1.75	9-23-64	Labor	33.96
1/2	lb. Grass Seed @1.10		.55	12'	3/4" Copper tubing @.42	5.04
2	hrs. Trucking @3.00		6.00	1	3/4" Corp Cock	7.41
2	hrs. Shovel @6.50		13.00	1	3/4" Curb Cock	8.76
			87.93	1	1" Lead lined Coup.	.54
8	WATER CHANGE TO NEW MAIN			1	1 x 5 G.L. Nipple	.65
9/23/64	1 3/4" corp cock			1	1" Style 38 Coup.	3.35
	1 3/4" curb cock			1	hr. Town Shovel	6.50
	12' 3/4" copper tubing			1	hr. Town Truck	3.00
	1 1" coupling					69.21
	1 1" Nipple					
	1 1" Style 38 clamp					

DATE _____

TOWN OF LEXINGTON — BOARD OF PUBLIC WORKS

WATER DIVISION

Sketch of Service Here

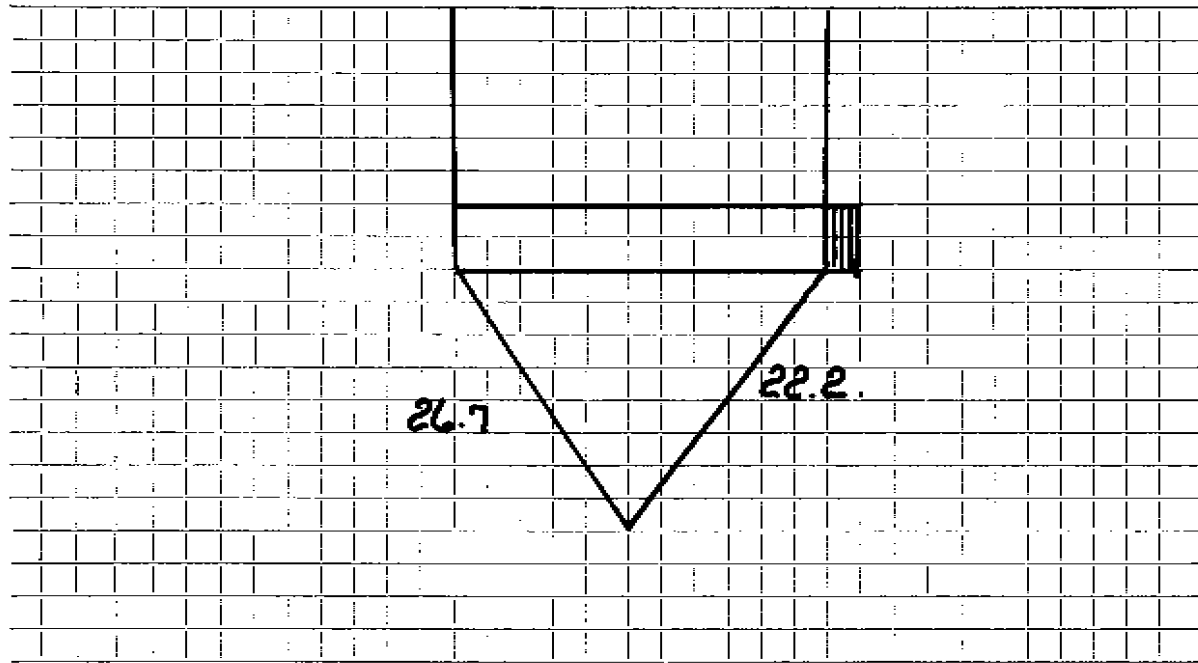

Connection made in Street. Work completed

Remarks:
.....
.....