

WATER SERVICE RECORD

Name Benjamin Gott

Service No. 76

Address 38 Brandon Street

Location Lexington

Repair—Renewal—New Service

Om. 7-28-52


Date	Material	Amount	Total	Date	Amount
6/5/52	Labor	1 63		5-1-52 7-28-52	25 00 13 48
	10% Overhead	16	1 79		21 32
	43'-3/4" Copper tubing @ .3439	14 78			
	1-3/4" C x 1/2 I.W.H. Stop & Waste	4 00		6/5/52	Labor 1 63
	1 hr. trucking		75	28' - 3/4" Copper tubing @ .3439	9 63
			21 32	1 - 3/4" C x 3/4" C Union 3 pts.	1 72
				1 - 3/4" C x 3/4" C. Curb-Cock	4 67
				1 Box and Rod	4 52
				1-1/2 offset tail piece	50
				1-1/2 straight tail piece	50
				1 hr. trucking	75
					23 92
	<u>WATER CHANGE TO NEW MAIN</u>				
9-23-64	1 3/4" Corp Cock				
	1 3/4" Union				
	2' 3/4" Copper tubing				

DATE _____

TOWN OF LEXINGTON — BOARD OF PUBLIC WORKS

WATER DIVISION

Sketch of Service Here

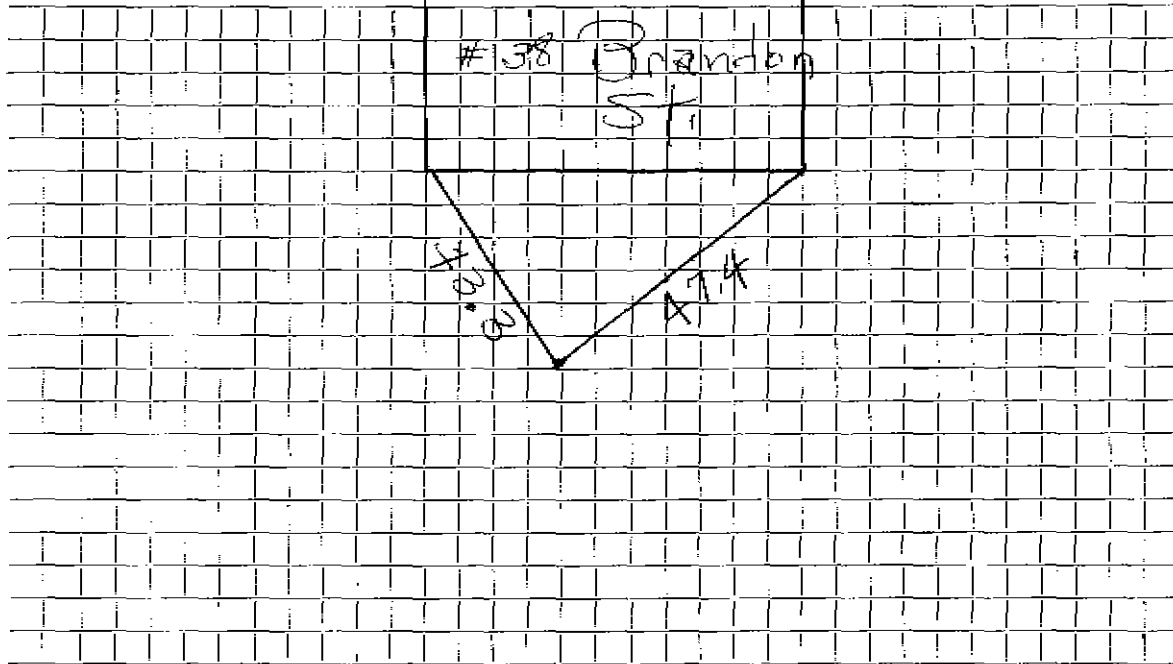

Connection made in Street. Work completed

Remarks:

.....

.....