

Name

Service No. 389

Address

Location 40 Brandon St.

Kind of Pipe

Size

Size of Main

Repair—Renewal—New Service

Location

Date

Material

Amount

Total

Date

Amount

## CURB TO MAIN

9/24/64	Labor	22 64
	10% overhead	2 26
	26' 3/4" copper tubing @ .42	10 92
	1 3/4" corp cock	7 41
	1 curb box	4 90
	1 hr. town shovel	6 50
	1 hr. town truck	3 00
		<hr/> 63 63

WATER CHANGE TO NEW MAIN

9-24-64

1 3/4" Corp Cock	
26' 3/4" Copper tubing(out)	
1 Curb Box	
Labor	

DATE \_\_\_\_\_

# TOWN OF LEXINGTON—BOARD OF PUBLIC WORKS

## WATER DIVISION

The undersigned applies for a supply of water at No. \_\_\_\_\_ St. and hereby agrees to comply with the rules and regulations as now, or at any future time, established by the Board of Selectmen.

Am't. of Estimate \$ \_\_\_\_\_

Owner

Dorothy Van Gemert


Am't. Paid \$ \_\_\_\_\_

Address

40 Brandon St.

Builder \_\_\_\_\_

Sketch of Service Here

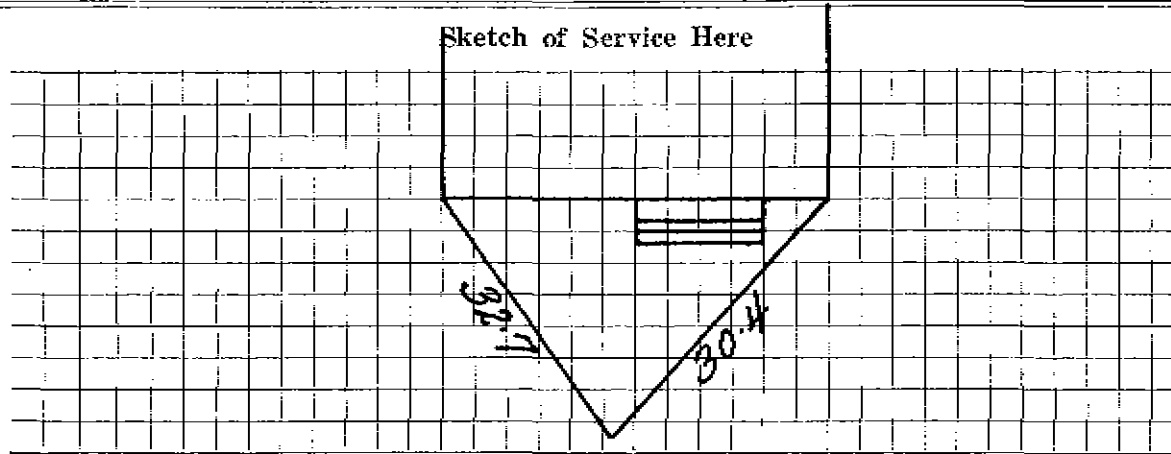

Connection made in \_\_\_\_\_ Street.

Work completed \_\_\_\_\_ 19

Remarks: