

Name Benjamin Gott

WATER SERVICE RECORD

Service No. 192

Address 45 Brandon Street

Location Lexington

~~Repair~~ ~~Renewal~~ New Service

Case 11-3-52


Date	Material	Amount	Total	Date	Amount
9/24/52	Labor	1 63		8-29-52	Deposited 25 00
	10% Overhead	16	1 79	11-5-52	Refunded 5 54
	38' - 3/4" Copper tubing @ .34	12 92			<u>NON CHARGE</u> 19 46
	1 - 3/4" C x 1/2 I.W.H. stop & waste	4 00	9/24/52	Labor	1 63
	1 hr. trucking		75	8' - 3/4" Copper tubing @ .34	2 72
			19 46	1 - 3/4" C x 3/4" C. Union 3 pts.	1 72
	<u>WATER CHANGE TO NEW MAIN</u>			1 - 3/4" C x 3/4" C. curb-cock	4 67
9-18-64	1 1/4' 3/4" Copper tubing			1 box and rod	3 90
	1 3/4" Corp Cock			1 - 1/2 straight tail piece	50
				1 - 1/2 offset tail piece	50
				1 hr. trucking	75
					<u>16 39</u>

DATE _____

TOWN OF LEXINGTON — BOARD OF PUBLIC WORKS

WATER DIVISION

Sketch of Service Here

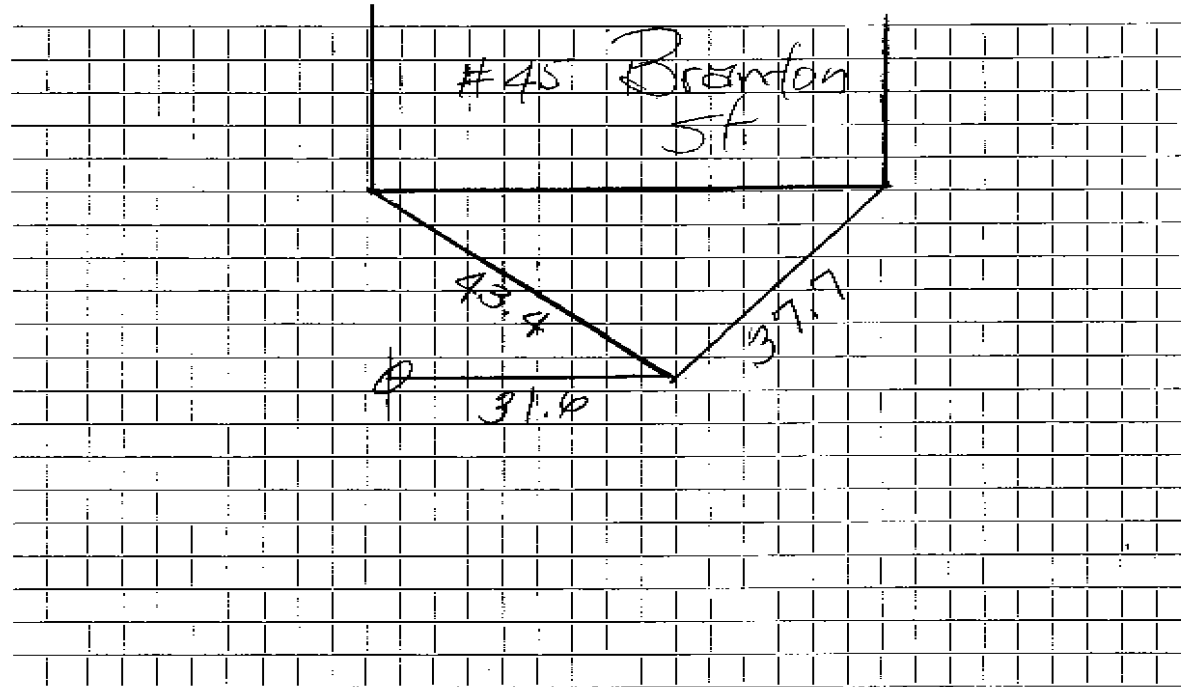

Connection made in Street. Work completed

Remarks:

.....
.....