


TOWN OF LEXINGTON — BOARD OF PUBLIC WORKS

WATER DIVISION

DATE _____

Sketch of Service Here

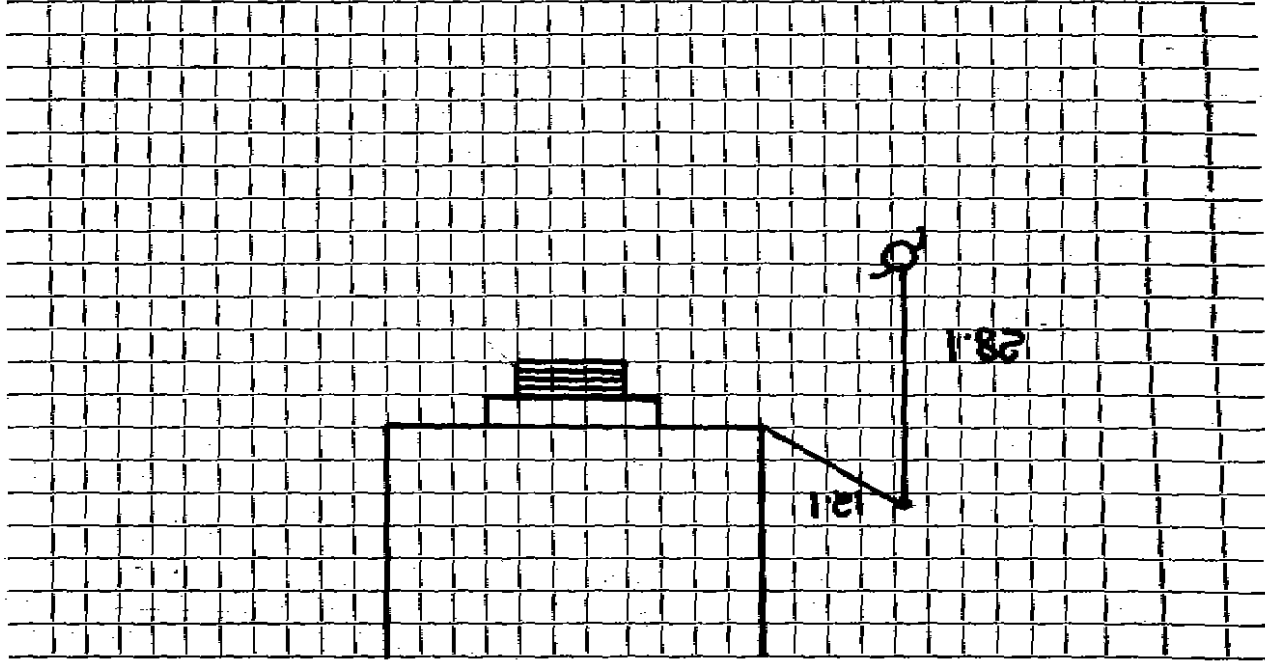

Work completed

Street

Connection made in

Remarks: