

Name Annie E. & Howard E. Storer

Service No. ~~42~~ 383

Address ~~74~~ Brandon Street

6157

Location

Kind of Pipe

Size

Size of Main

Repair—Renewal—New Service

Location

Date	Material	Amount	Total	Date	Amount
9/15/34	33 1" C.L. Pipe @.20	6 60		<i>Sept. 4 1934 - Reopened</i>	15 30
<i>Com. 15.30 to Russell 11-27-34</i>	2 1" L.L. Coup. @.25	50			
	1 1" L.L. Ell	30			
	1 1" Br. Nipple	15			
	1 S & W Trucking	2 75	\$11 05		
	3 Hrs. Labor @.55	1 65			
	2 " " @.60	1 20	2 85		
	10 ⁰⁰ Overhead		29		
	COST		14 19		
	Labor				
	Deposit of	\$15 30	\$15 30		
	Sewer service exceeded estimate, and will credit this 45¢ to that acct.				

Hadley Press, Inc., Lexington

CHARGE

34 1/2 .45

DATE _____

TOWN OF LEXINGTON—BOARD OF PUBLIC WORKS WATER DIVISION

The undersigned applies for a supply of water at No. _____ St. and hereby agrees to comply with the rules and regulations as now, or at any future time, established by the Board of Selectmen.

Am't. of Estimate \$ 15-30

Owner Archie Leonard Howard E. Storer


Am't. Paid \$ _____

Address 7 A Brandon St

Builder _____

Lexington, Mass.

Sketch of Service Here

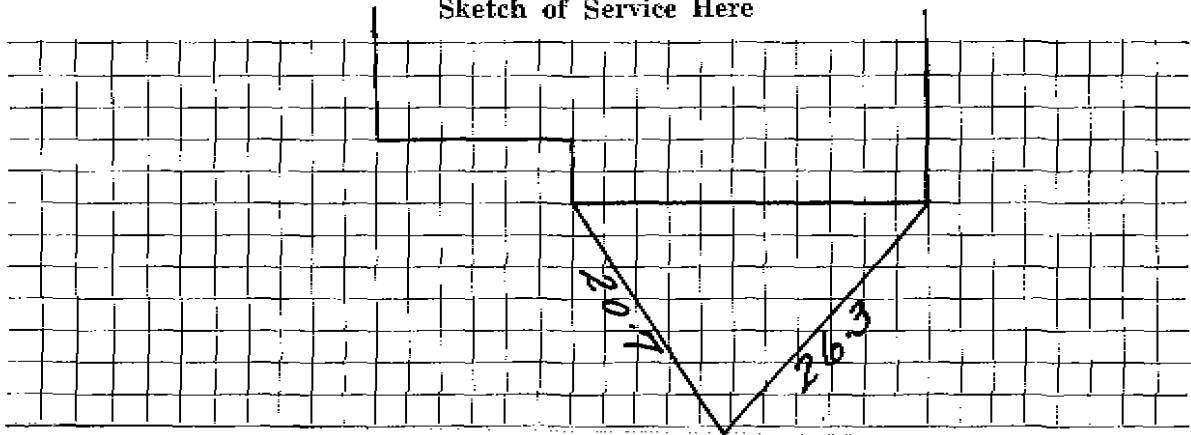

Connection made in _____ Street. Work completed _____ 19__

Remarks: