


DATE _____

TOWN OF LEXINGTON — BOARD OF PUBLIC WORKS

WATER DIVISION

Sketch of Service Here

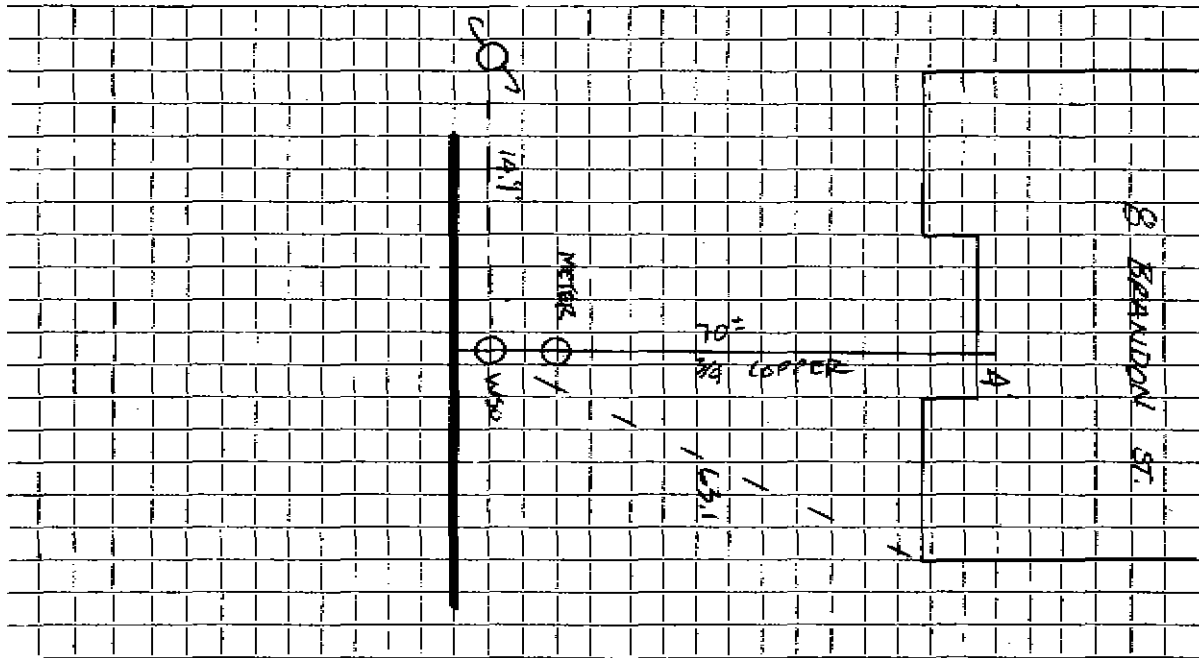

Connection made in Street. Work completed

Remarks:
.....
.....

Name Chester Banks
 Address 8 Brandon St.
~~15 Leine Road, Arlington.~~

¹¹⁶⁴
 Service No. # 384

Location #8 Brandon Street

Kind of Pipe _____ Size _____ Size of Main _____
~~Repair - Renewal~~ - New Service _____ Location _____

Date	Material	Amount	Total	Date	Amount
Apr. 4, 1939	2 hrs. @ 60¢		1 20	March 30, 1939	16 00
COM 4-11-39	34' 3/4" Copper Tubing @ 20¢		6 80	Deposited	
	1 3/4" S. & W.		3 75		
	1 1" L.L.Tee		65		
	1 3/4" 6x1 Union		1 10		
	Trucking, 2 hrs. @ 75¢		1 50		
			<u>15 00</u>		
	Flat Rate:				
	32' @ 50¢		\$ 16 00		
	Labor				

Hadley Press, Inc., Lexington

DATE March 30, 1939

TOWN OF LEXINGTON—BOARD OF PUBLIC WORKS

WATER DIVISION

The undersigned applies for a supply of water at No. Lot 16757, Brauder (#8) St. and hereby agrees to comply with the rules and regulations as now, or at any future time, established by the Board of Selectmen.

Am't. of Estimate \$ 16-

Owner Lehman Bank


Am't. Paid \$ _____

Address 14- Lane Rd

Builder _____

Arlington

Sketch of Service Here

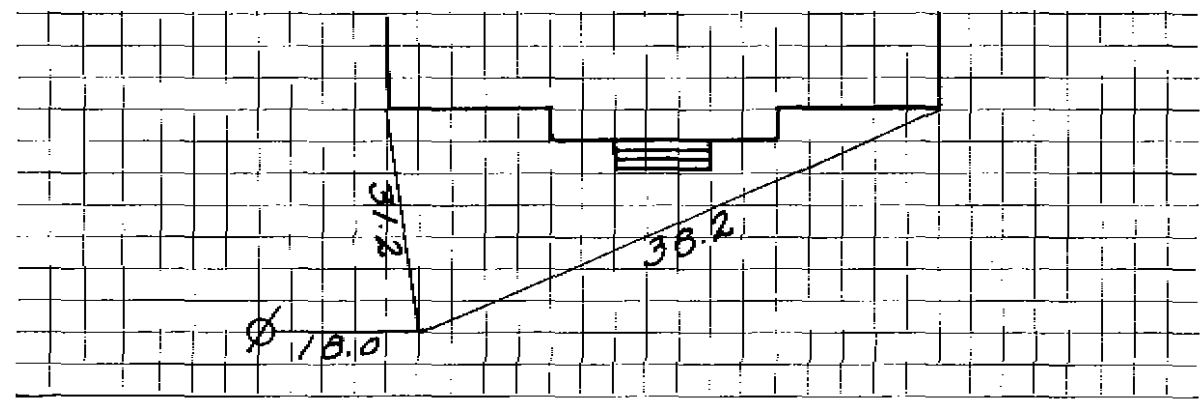

Connection made in _____ Street.

Work completed _____ 19

Remarks: