


DATE _____

TOWN OF LEXINGTON — BOARD OF PUBLIC WORKS
WATER DIVISION

Sketch of Service Here

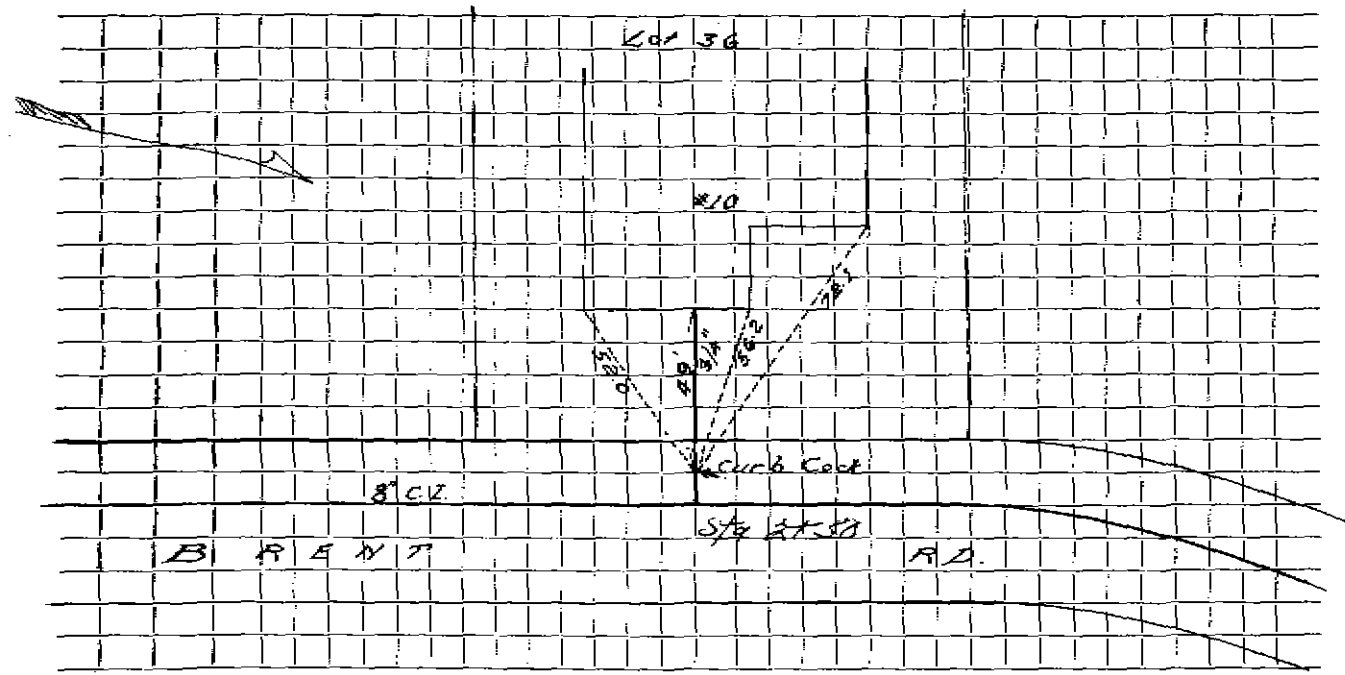

Connection made in _____ Street. Work completed _____

Remarks: _____

WATER SERVICE RECORD

Name Joseph E. Trodella

Service No. 66

Address 10 Brent Rd.

Location

W.O. 1525

Repair—Renewal—New Service

DeFlica Bros. # 2437


FEB 10 1975

Date	Material	Amount	Total	Date	Amount	
				11-28-73	Deposit	72.34
11-24-73	75'-1" Copper					
11-9-73	Labor	7.54				
	10% O.H.	.75	8.29			
	14' 1" Copper tubing @1.35		18.90			
	1 1" Curb		16.98			
	1 1" Corp		15.17			
	1 Box & Rod		10.00			
	1 hr. Trucking @3.00		3.00			
			72.34			

DATE _____

TOWN OF LEXINGTON — BOARD OF PUBLIC WORKS
WATER DIVISION

Sketch of Service Here

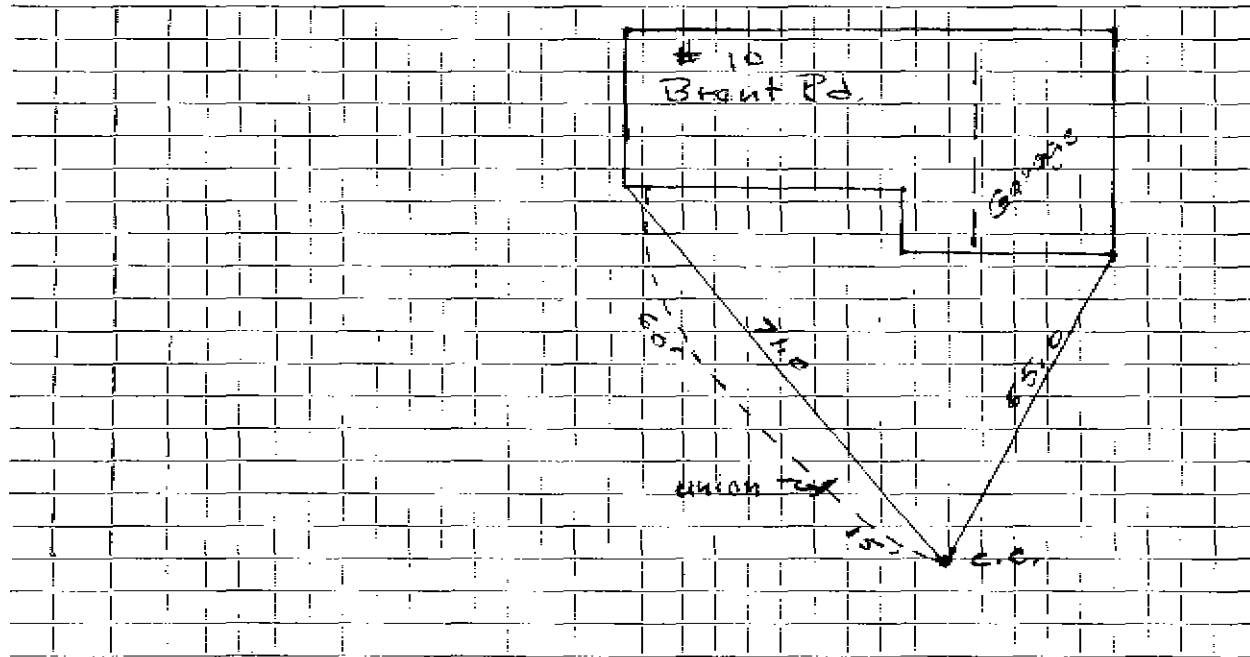

Connection made in Street. Work completed

Remarks:

.....

.....