


DATE _____

TOWN OF LEXINGTON — BOARD OF PUBLIC WORKS

WATER DIVISION

Sketch of Service Here

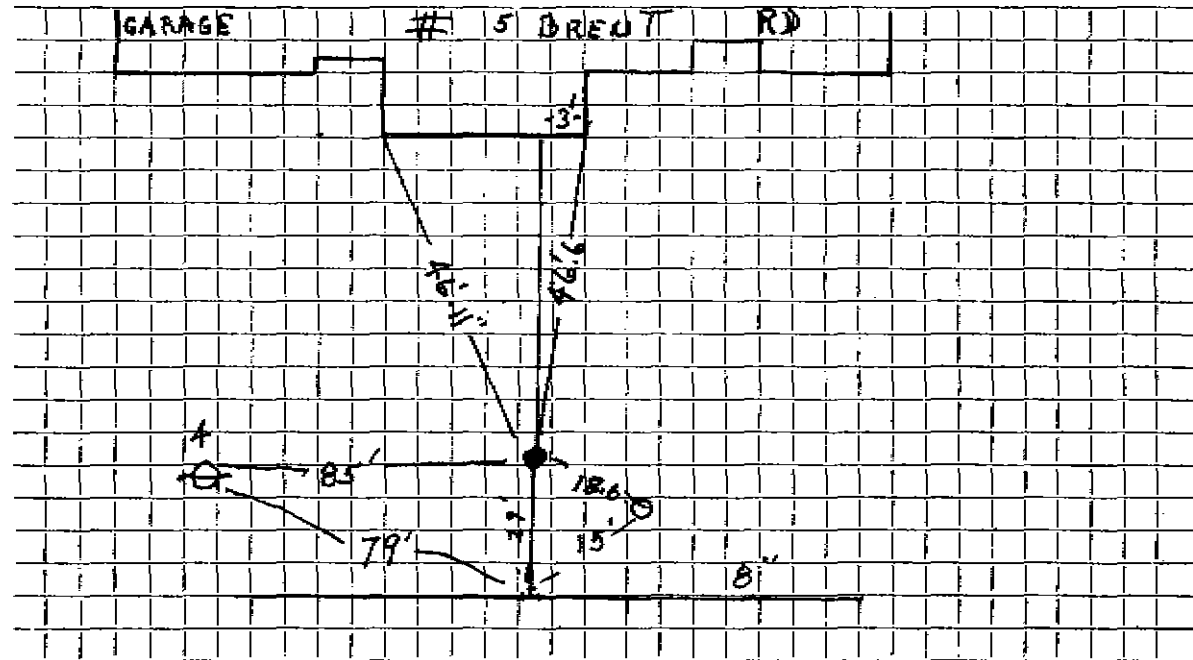

Connection made in Street. Work completed

Remarks: WATER MAIN IN GRASS PLOT.....
WATER SERVICE INSIDE 2" SLEEVE WHERE SEWER CROSSES IT.....