

WATER SERVICE RECORD

#6409

Name William Sullivan

Service No. 120

Address 6 Brent Road

Location

~~Repair - Renewal~~ - New Service

Cans 11-24-58


Date	Material	Amount	Total	Date	Amount	
6/28/58	Labor	2 10		6-20-58	Deposited	25 10
	10% overhead	21		2-25-59	Paid	4 99
			2 31			29 99
	57' 3/4" copper tubing @.37	21 09				
	1 3/4" Cx 1/2 IWH stop & waste	5 84			NON CHARGE	
	1 hr. trucking @.75	75			labor	1 53
			29 99		8' 3/4" copper tubing @.37	2 96
					1 3/4" C corp cock	4 64
					1 3/4" C curb cock	6 03
					1 box & rod	5 00
					1 1/2 straight tail pc.	50
					1 1/2 offset tail pc.	50
						21 16

DATE _____

TOWN OF LEXINGTON — BOARD OF PUBLIC WORKS

WATER DIVISION

Sketch of Service Here

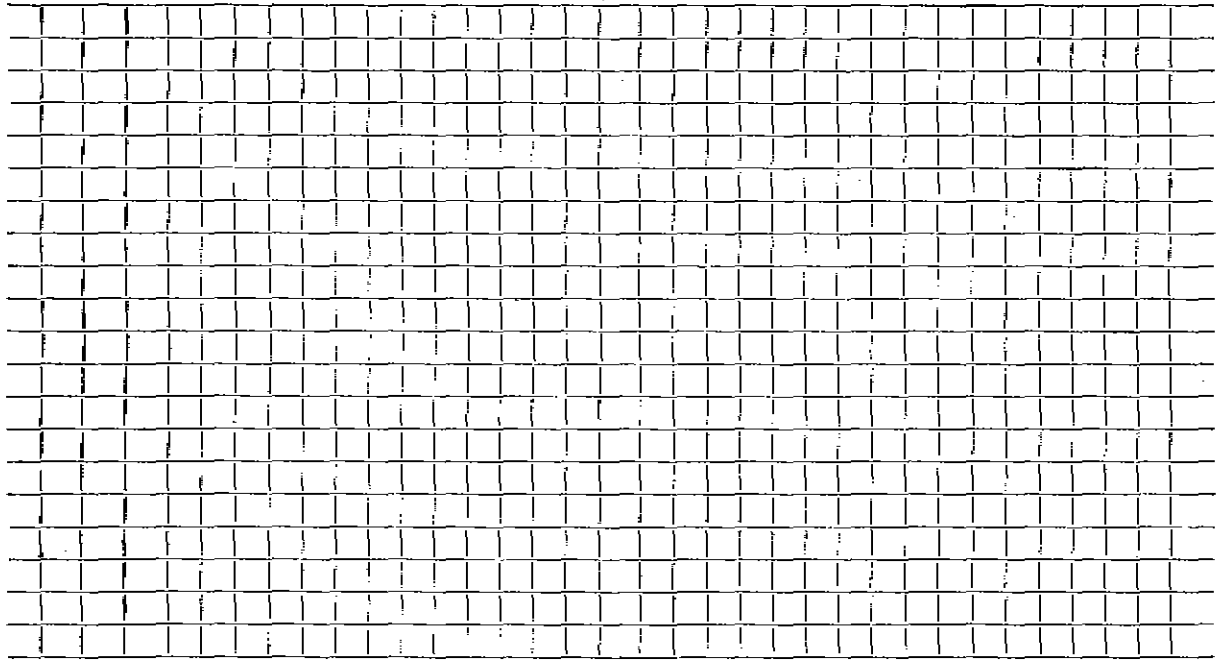

Connection made in Street. Work completed

Remarks:
.....
.....