

WATER SERVICE RECORD

2345
Service No. 115

Name Esco Bldrs.

Address 7 Brent Road

Location

xx ~~Repair~~ ~~Renewal~~ — New Service

Comm 11-24-58

Date	Material	Amount	Total	Date	Amount
6/23/58	Labor	1 88			25 00
	10% overhead	19			81
			2 07		98
	49' 3/4" copper tubing @.37	18 13			26 79
	1 3/4" Cx 1/2 IWH stop & waste	5 84			1 53
	1 hr. trucking @.75	75			35' 3/4" copper tubing .37
			26 79		1 3/4" C corp cock
					12 95
					4 64
					1 3/4" C curb cock
					6 03
					1 box & rod
					5 00
					1 1/2 straight tl. pc.
					50
					1 1/2 offset tail pc.
					50
					31 15


Bill *11-24-58* *98*

DATE _____

TOWN OF LEXINGTON — BOARD OF PUBLIC WORKS

WATER DIVISION

Sketch of Service Here

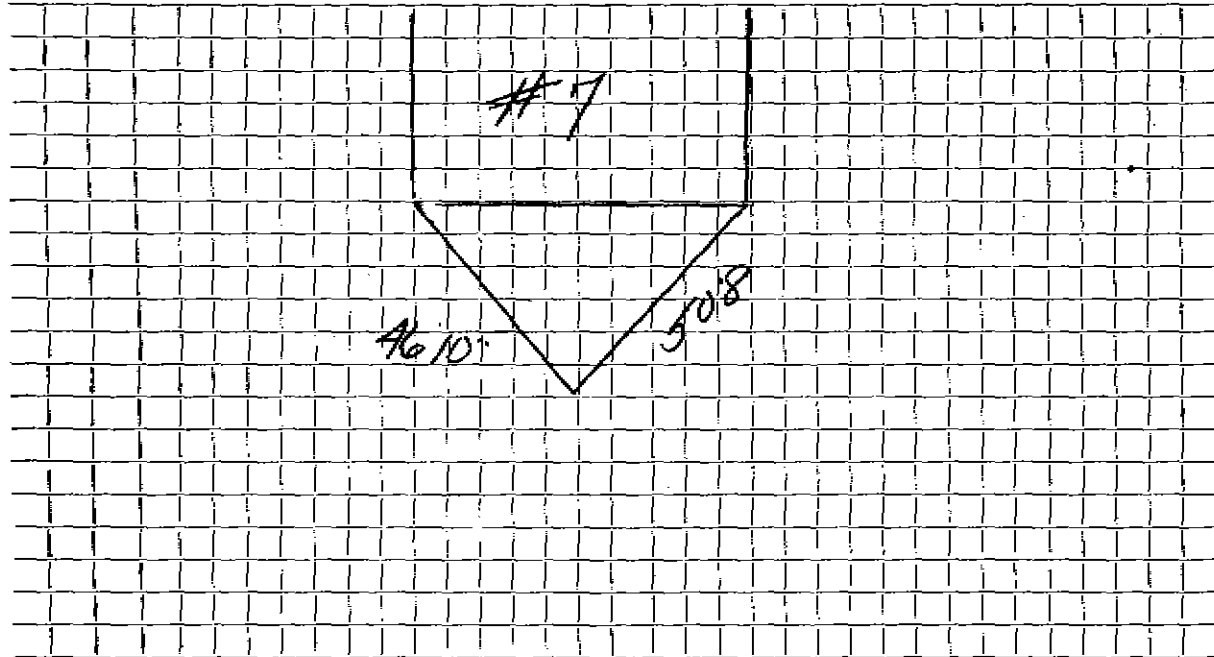

Connection made in Street. Work completed

Remarks:

.....

.....