

WATER SERVICE RECORD

Name Ivar W. Skoog

Service No. 134

Address 14 Bridge Street

Location Lexington

REPAIRS - New Service

Com. 9-22-52

| Date | Material | Amount | Total | Date | Amount |
|---------|-------------------------------------|--------|-------|---------------------------------|-------------------|
| 8/23/52 | Labor | 4 96 | | 7-10-52 Deposited | 50 00 |
| | 10% overhead | 50 | 5 46 | 9-22-52 Refunded | (10 31) |
| | 45' - 3/4" copper tubing@ .3439 | 15 48 | | | <u>NON CHARGE</u> |
| | 1 -3/4" C x 1/2 I.W.H. stop & waste | 4 00 | | 8/23/52 Labor | 4 97 |
| | 2 hrs. Littlefield shovel | 14 00 | | 28' - 3/4" copper tubing@ .3439 | 9 63 |
| | 1 hr. trucking | | 75 | 1 -3/4" C. corp-cock | 4 33 |
| | | | 39 69 | 1 -3/4" C x 3/4" C. curb-cock | 4 67 |
| | | | | 1 box and rod | 3 90 |
| | | | | 1 -1/2 offset tail piece | 50 |
| | | | | 1 -1/2 straight tail piece | 50 |
| | | | | 2 hrs. Littlefield shovel | 14 00 |
| | | | | 1 hr. trucking | 75 |
| | | | | | <u>43 25</u> |

DATE _____

TOWN OF LEXINGTON — BOARD OF PUBLIC WORKS

WATER DIVISION

Sketch of Service Here

A large grid of graph paper, approximately 20 columns wide and 25 rows high, intended for sketching service details.

Connection made in Street Work completed

Remarks:

.....


.....

DATE 7-19-1999

TOWN OF LEXINGTON — BOARD OF PUBLIC WORKS

WATER DIVISION

Sketch of Service Here

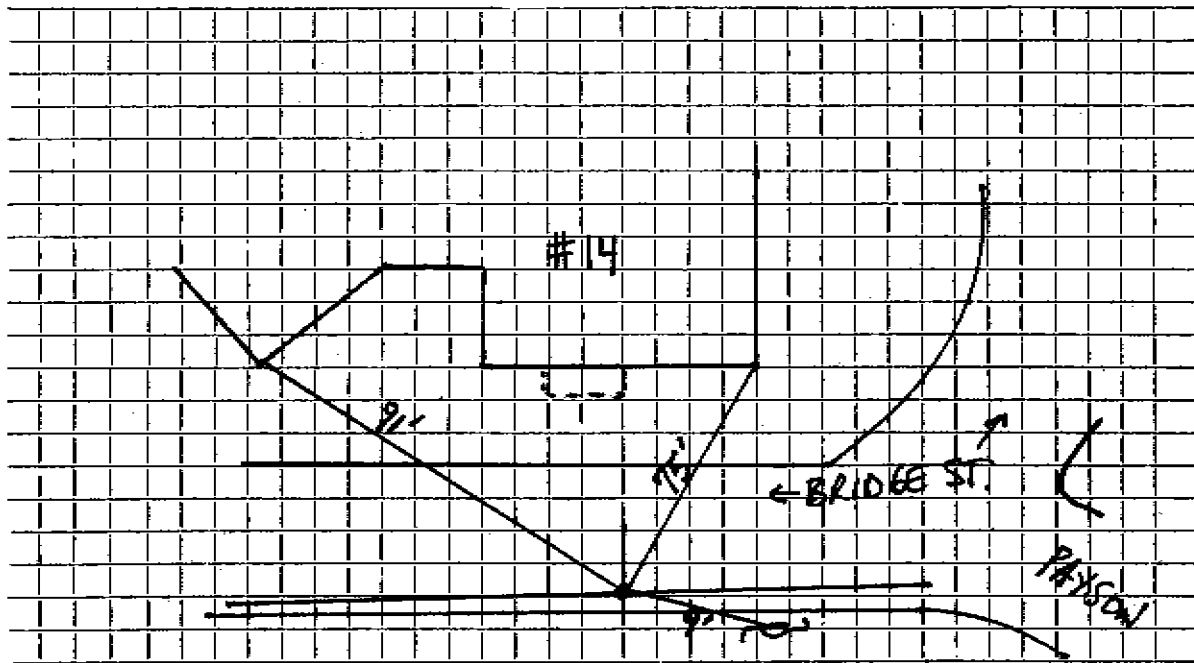

Connection made in 8" Main, EAST SIDE OF BRIDGE Street.

Work completed NEW COOPERATION, Union

Remarks: