


DATE 2/27

TOWN OF LEXINGTON — BOARD OF PUBLIC WORKS
WATER DIVISION

Sketch of Service Here

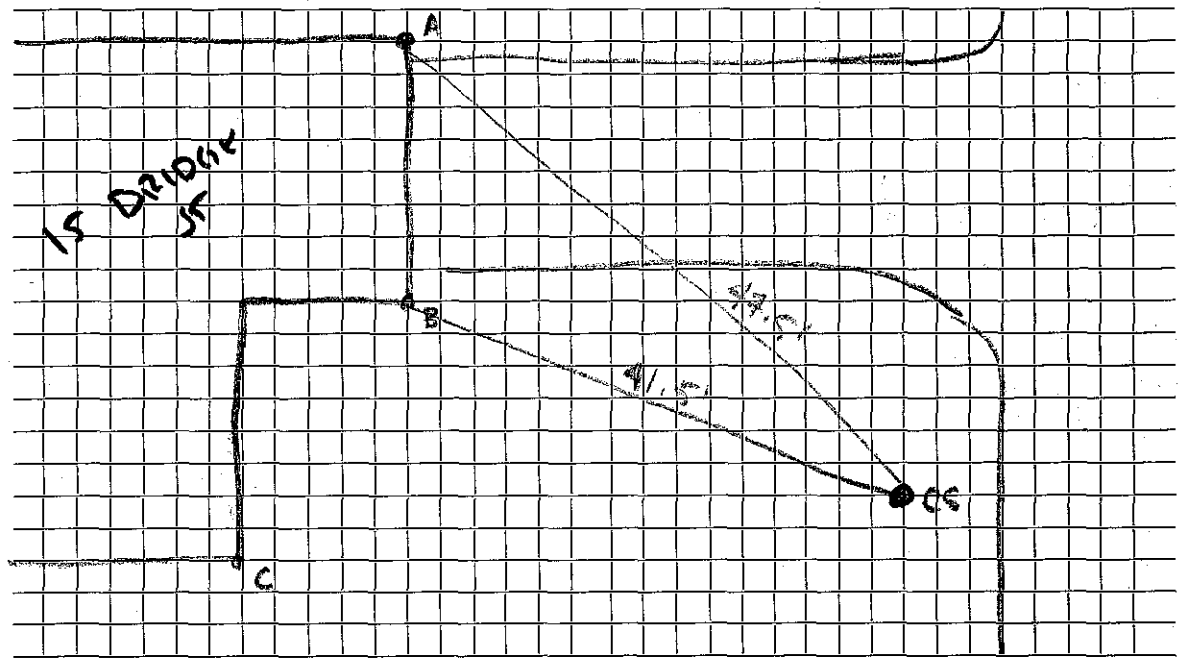

Connection made in Bridge Street. Work completed

Remarks: