




DATE 9/20/17

TOWN OF LEXINGTON — BOARD OF PUBLIC WORKS  
WATER DIVISION

Sketch of Service Here

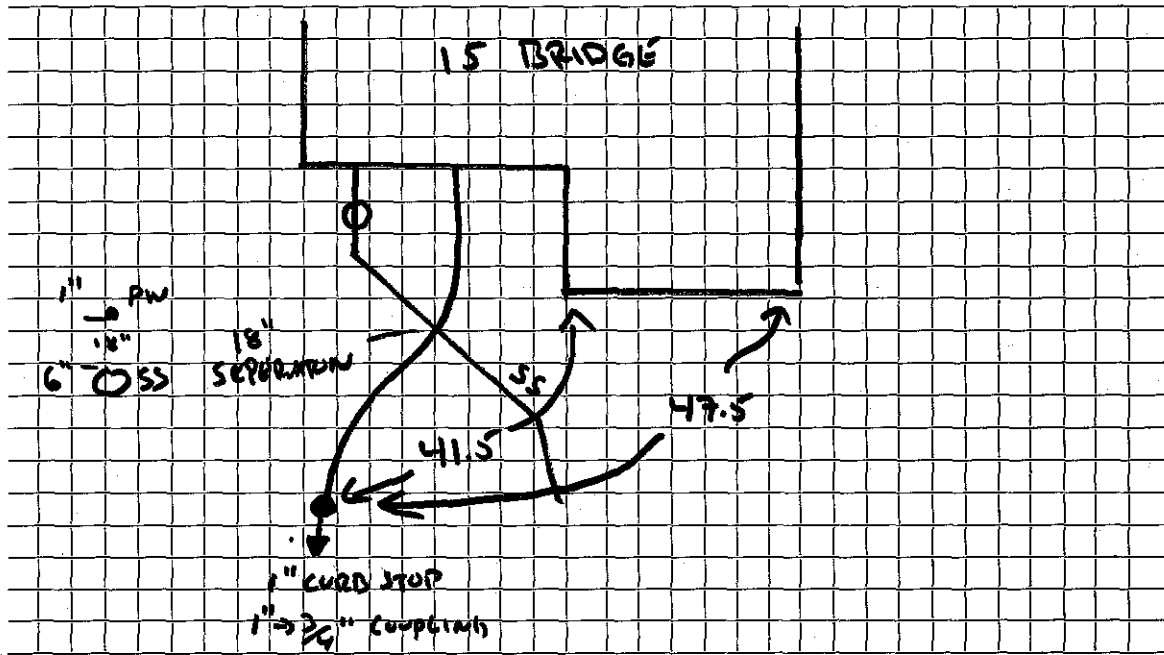

Connection made in ..... Street.

Work completed GREG GULLAGE JR .....

Remarks: .....  
.....  
.....