

Deposit paid by
 Name **United Construction Co.,**
 Address **20 Liberty Street, Everett, **

Owner
Allan F. Fougstedt

Service No. ~~100~~ **394**
3133

Location **17 Bridge St.,**

Kind of Pipe

Size

Size of Main

Repair—Renewal—New Service

Location

Date 1941	Material	Amount	Total	Date	Amount
Sept. 3, <i>from 9/15/41</i>	4 hrs. @ 60¢	2 40		September 7, 1941	20 00
	10% Overhead	<u>24</u>	2 64	September 16, 1941	<u>6 33</u>
	37' 3/4" Copper tubing @ 19¢	7 03	7 03		13 67
	1 3/4" C.S.& W.	2 50	2 50		
	2 hrs. trucking @ 75¢	<u>1 50</u>	<u>13 67</u>		
	Labor				

Hadley Press, Inc., Lexington

DATE Aug 28 1941

TOWN OF LEXINGTON—BOARD OF PUBLIC WORKS

WATER DIVISION List 199 + Part 200.

The undersigned applies for a supply of water at No. 17 Bridge St. and hereby agrees to comply with the rules and regulations as now, or at any future time, established by the Board of Selectmen.


Am't. of Estimate \$ 20.00

~~Owner~~ Clarence F. Fougstedt
Address _____

Am't. Paid \$ _____

Builder Wm. J. Conroy & Son

Sketch of Service Here

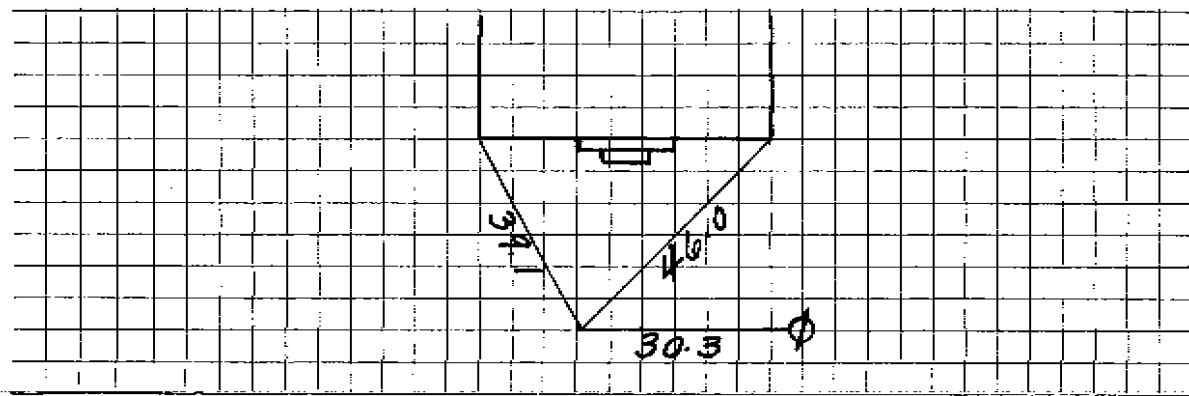


Connection made in _____ Street. Work completed _____ 19

Remarks:

DATE 7-19-1999

TOWN OF LEXINGTON — BOARD OF PUBLIC WORKS
WATER DIVISION

Sketch of Service Here

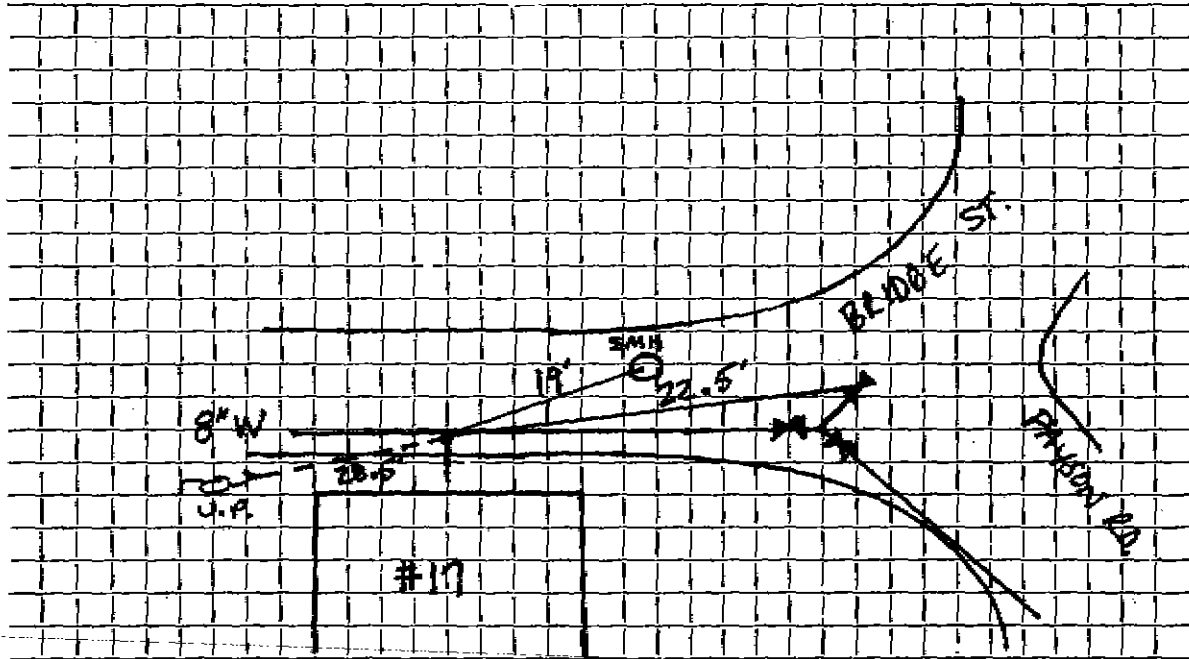

Connection made in 8" MAIN ON BRIDGE ST. Street.

Work completed NEW CORPORATION, UNION

Remarks: ADJACENT TO CONCRETE STAIRS.