

6823

WATER SERVICE RECORD

Name Bernard Maloney

Service No. 37

Address 22 Bridge Street

Location

~~Basic Service~~ New Service W.O. #7939


Comm 10-28-63

Date	Material	Amount	Total	Date	Material	Amount
5-27-63	Labor	21.48		5-16-63	Deposit	100.00
	10% O.H.	2.15	23.63	11-28-63	Refund	5.84
60'	3/4" Copper tubing @.42		25.20			94.16
1	3/4" G x 1/2 I.W.H. Stop & Waste		6.17		NON CHARGE	
1	3/4" G 3 part union		2.41		Labor	12.96
21'	x 3 Patch		21.00	36'	3/4" Copper tubing @.42	15.12
1 1/2	hrs. Town Shovel @6.50		9.75	1	3/4" G Corp Cock	4.91
2	hrs. Trucking @3.00		6.00	1	3/4" G Curb Cock	6.28
			94.16	1	Box & Rod	4.90
				1	1/2 Straight tailpiece	.50
				1	1/2 Offset tailpiece	.50
				1/2	hr. Town Shovel @6.50	3.25
						48.42

DATE _____

TOWN OF LEXINGTON — BOARD OF PUBLIC WORKS
WATER DIVISION

Sketch of Service Here

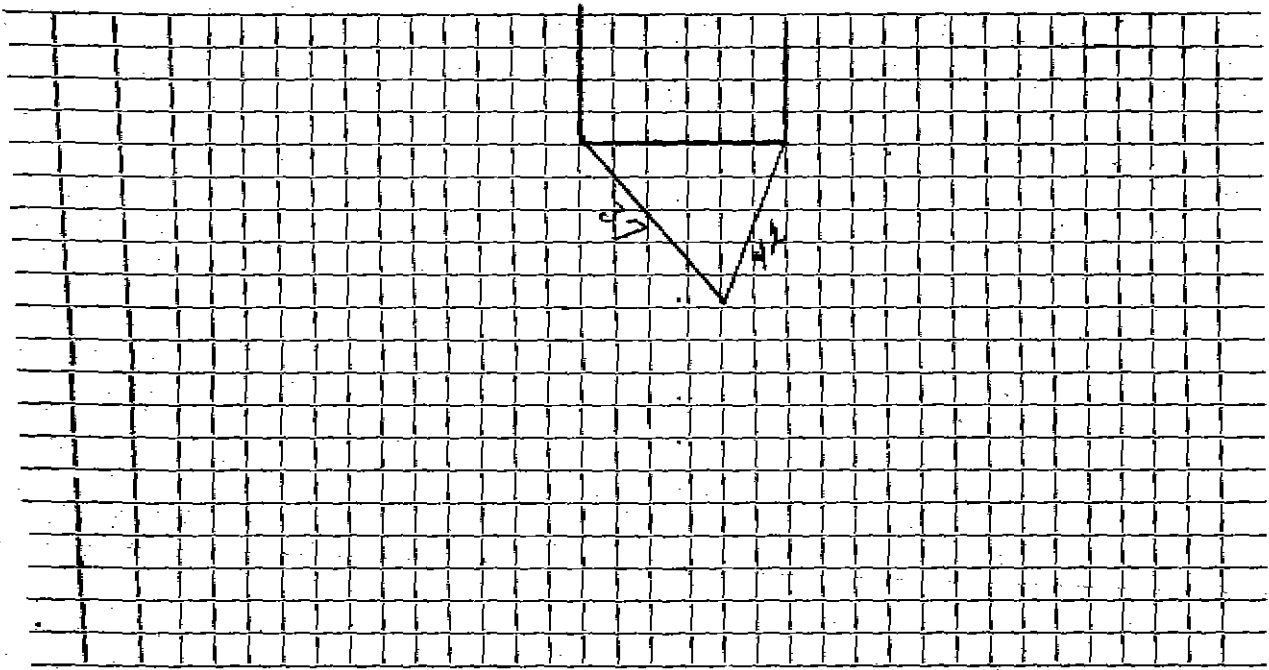

Connection made in Street. Work completed

Remarks:
.....
.....