

WATER SERVICE RECORD

Name Anthony Sacco

Service No. 104

Address 23 Bridge Street

Location

~~Repair~~ ~~Renewal~~ ~~Water Service~~ T. D. Sullivan Permit #A26

*May 3 '66*

Date	Material	Amount	Total	Date	Amount
10-15-65	Labor	3.05		10-4-66	30.00
	10% O.H.	.31	3.36	5-20-66	77
	36' 3/4" Copper tubing @.42		15.12		30.77
	1 3/4" G x 1/2 I.W.H. Stop & Waste		9.29		
	1 hr. Town Truck @3.00		3.00		
			30.77	10-18-66	
				35' 3/4" Copper tubing@.42	14.70
				1 3/4" Curb Cock	8.76
				1 1" Coupling	.74
				1 Adapter	1.08
				3 hrs. Town Shovel @6.50	19.50
				1 hr. Trucking @3.00	3.00
					83.71

*Deposit Paid*


CURB TO MAIN

DATE \_\_\_\_\_

**TOWN OF LEXINGTON — BOARD OF PUBLIC WORKS**

**WATER DIVISION**

Sketch of Service Here

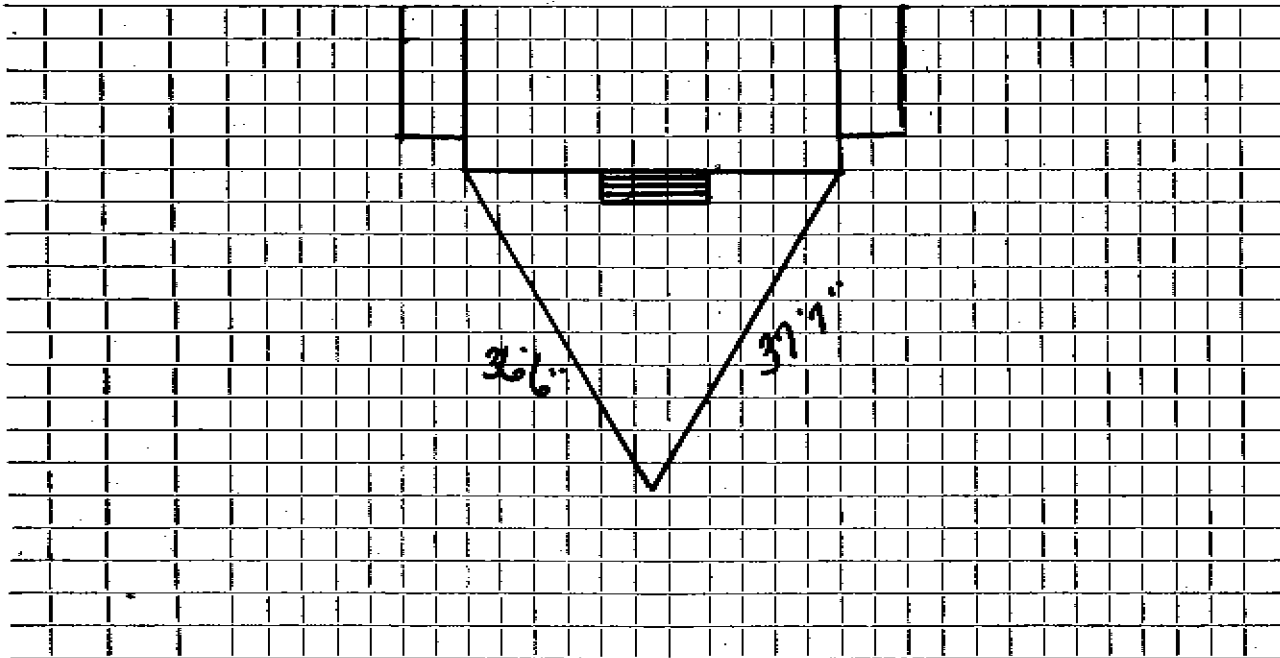

Connection made in ..... Street. Work completed .....

Remarks: .....  
.....  
.....