

Builder: A. Minotti  
Name (Aldo)

Owner: Charles Walmsley

Service No. <sup>81</sup> 396  
#4809

Address 681 Main St., Waltham

Location 24 Bridge St.,

Kind of Pipe

Size

Size of Main

~~Repair~~ ~~Renewal~~ — New Service

Location

Date 1940	Material	Amount	Total	Date	Amount
Oct. 30	34 hrs. @ 60¢	20 40		October 19, 1940 Deposited	40 00
Com 11/14/40	10% Overhead	2 04	22 44	November 25, 1940 Refunded	8 05
	32' 3/4" Copper tubing @ 18¢	5 76			31 95
	1 3/4" G.x 1/2" I.S. & W.	2 25			
	2 hrs. trucking @ 75¢	1 50			
			31 95		
	Labor				

Hadley Press, Inc., Lexington

DATE July 1, 1924

# TOWN OF LEXINGTON—BOARD OF PUBLIC WORKS

## WATER DIVISION

The undersigned applies for a supply of water at No. 24 Bridge St St. and hereby agrees to comply with the rules and regulations as now, or at any future time, established by the Board of Selectmen.

Am't. of Estimate \$ 14<sup>00</sup>/<sub>100</sub>


Owner Charles W. Wainwright

Am't. Paid \$ \_\_\_\_\_

Address 5 Waltham St.

Builder \_\_\_\_\_

Sketch of Service Here

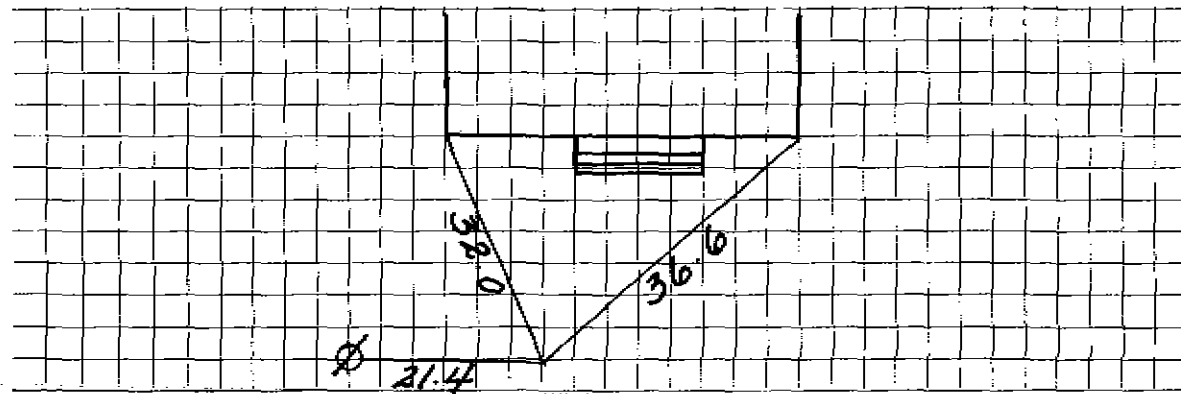

Connection made in \_\_\_\_\_ Street. Work completed \_\_\_\_\_ 19

Remarks: