

WATER SERVICE RECORD

Name

Service No.


Address 25 Bridge Street

Location

~~RENTAL - MAINTENANCE - SERVICE~~ RENT A SERVICE FROM CURB TO MAIN

Remarks:

Connection made in Work completed Street.

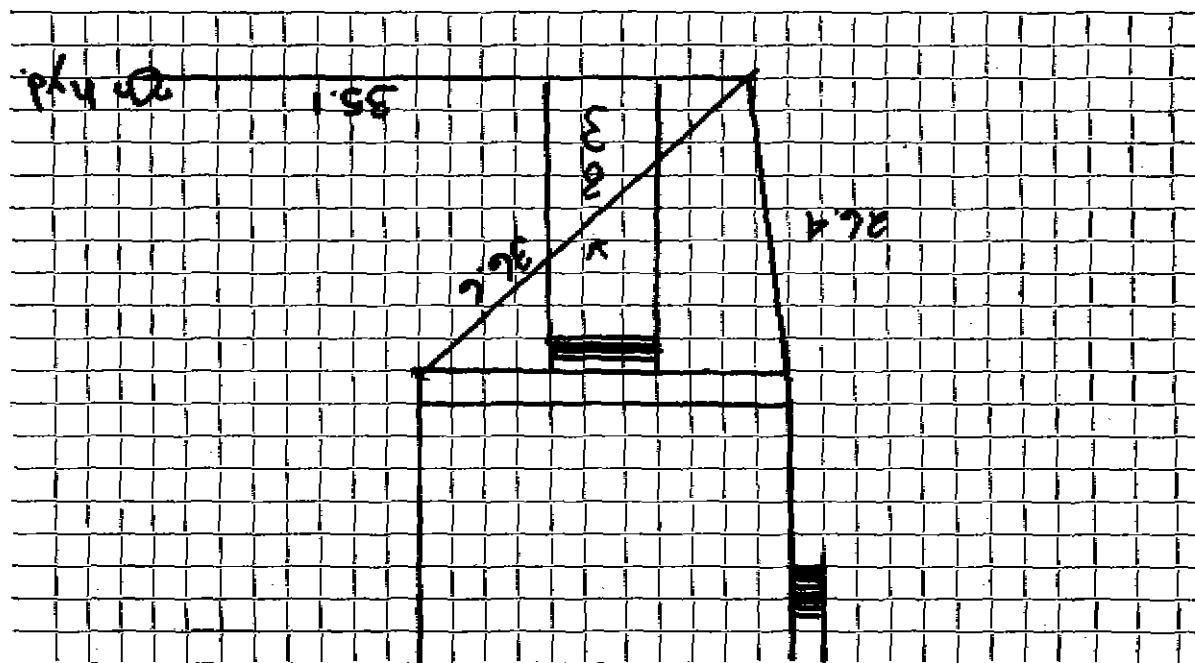

Sketch of Service Here

WATER DIVISION

TOWN OF LEXINGTON — BOARD OF PUBLIC WORKS

DATE