

WATER SERVICE RECORD

Name Hourihan

Service No.

Address

Location 28 BRIDGE ST


Repair—Renewal—New Service

Date		Material	Amount	Total	Date		Material	Amount
MAR 13	47	34'-3/4 COPPER			MAR 13	47	29' 3/4 COPPER	
		3/4 x 1/2 S & W					1 3/4 COUPL	
		1 3/4 UNION 3 PART					1 3/4 COUPL	
							1 Box + Rod	
							RENEW 17' MAIN TO UNION	
					12-18	92	17'-3/4 COPPER	
							1 3/4 UNION COMP	
							INSULATION AT COUPL 3 1/2' DEEP	
							INS BY GUTTER	

DATE _____

TOWN OF LEXINGTON — BOARD OF PUBLIC WORKS
WATER DIVISION

Sketch of Service Here

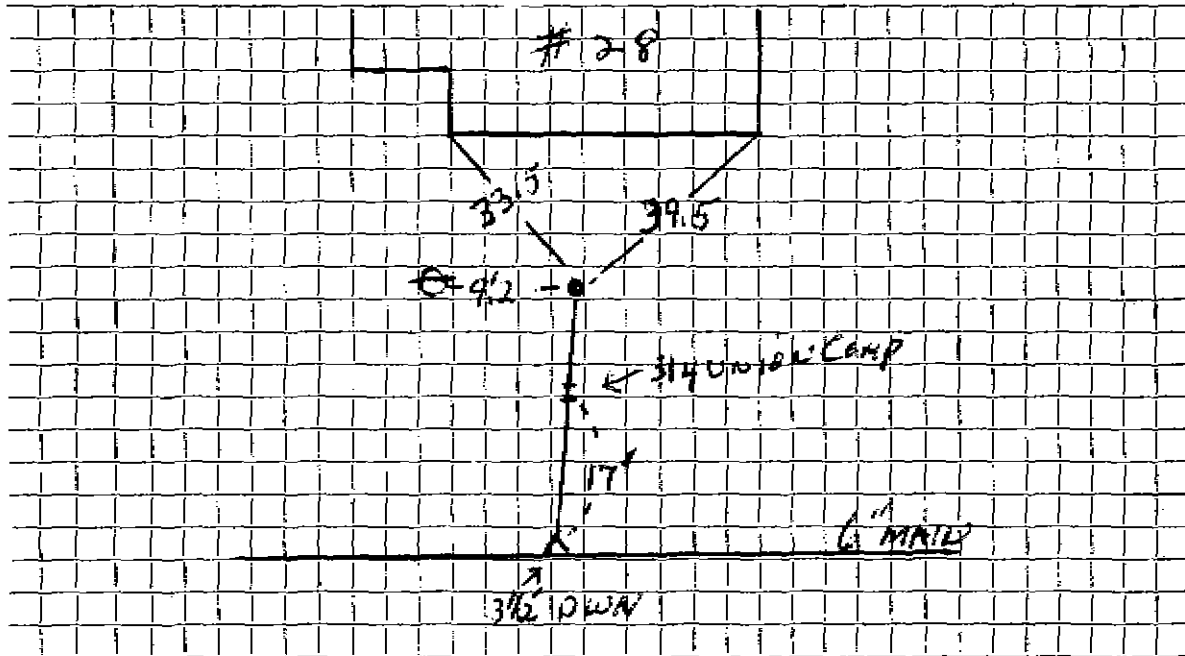

Connection made in Street. Work completed

Remarks:

.....

.....