

Name Clarence Penley
 Address 29 Bridge Street
 Lexington, Mass.

Service No. 115 6.

Location 29 Bridge Street

Kind of Pipe

Size

Size of Main

~~Repair - Renewal~~ - New Service

Com 12-30-46

Location

Date	Material	Amount	Total	Date	Amount
Dec. 27, '46	Labor	1 05	1 05	<i>Dec 23 '46</i>	<i>Deposited</i>
	10% Overhead		11	<i>Dec 31 '46</i>	<i>Refunded</i>
	30' - 3/4" Copper Tubing		8 10		Non-Charge
	1 - 3/4" C x 1/2" I.W.H. S & W		2 82	Dec. 27, '46	Labor
	Trucking 1 hr. @.75		75		15' - 3/4" Copper Tubing @.27
			12 83		1 - 3/4" C Corp-cock
					1 - 3/4" C x 3/4" C Curb-cock
					1 - Box & Rod
					Compressor 2 hrs. @1.75
					Trucking 1 hr. @.75
					1 - 1/2" Straight Tail Piece
					1 - 1/2" Offset Tail Piece
					<hr/>
					36 32
	<u>Trench Dug by Owner</u>				
	Labor				

DATE _____

TOWN OF LEXINGTON—BOARD OF PUBLIC WORKS

WATER DIVISION

The undersigned applies for a supply of water at No. _____ St. and hereby agrees to comply with the rules and regulations as now, or at any future time, established by the Board of Selectmen.

Am't. of Estimate \$ _____


Owner _____

Am't. Paid \$ _____

Address _____

Builder _____

Sketch of Service Here

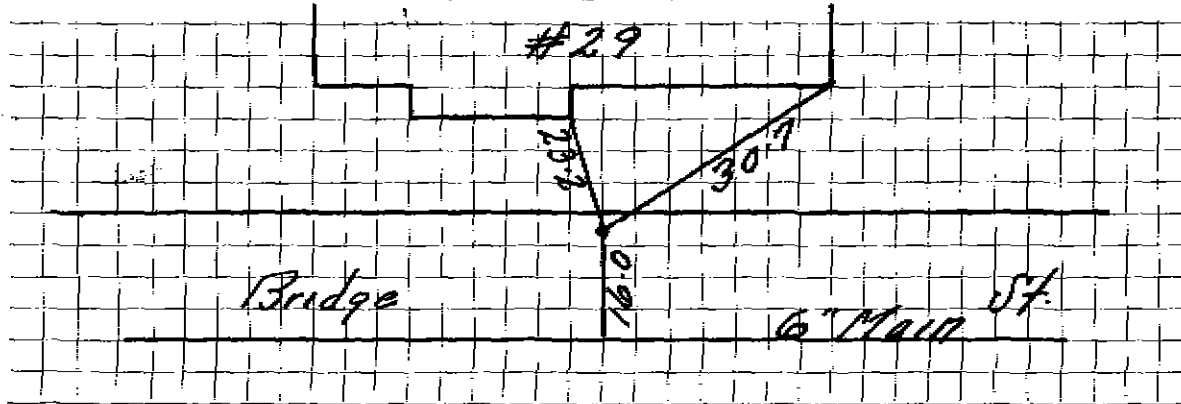

Connection made in _____ Street.

Work completed _____ 19

Remarks: