


DATE 2009

TOWN OF LEXINGTON — BOARD OF PUBLIC WORKS

WATER DIVISION

Sketch of Service Here

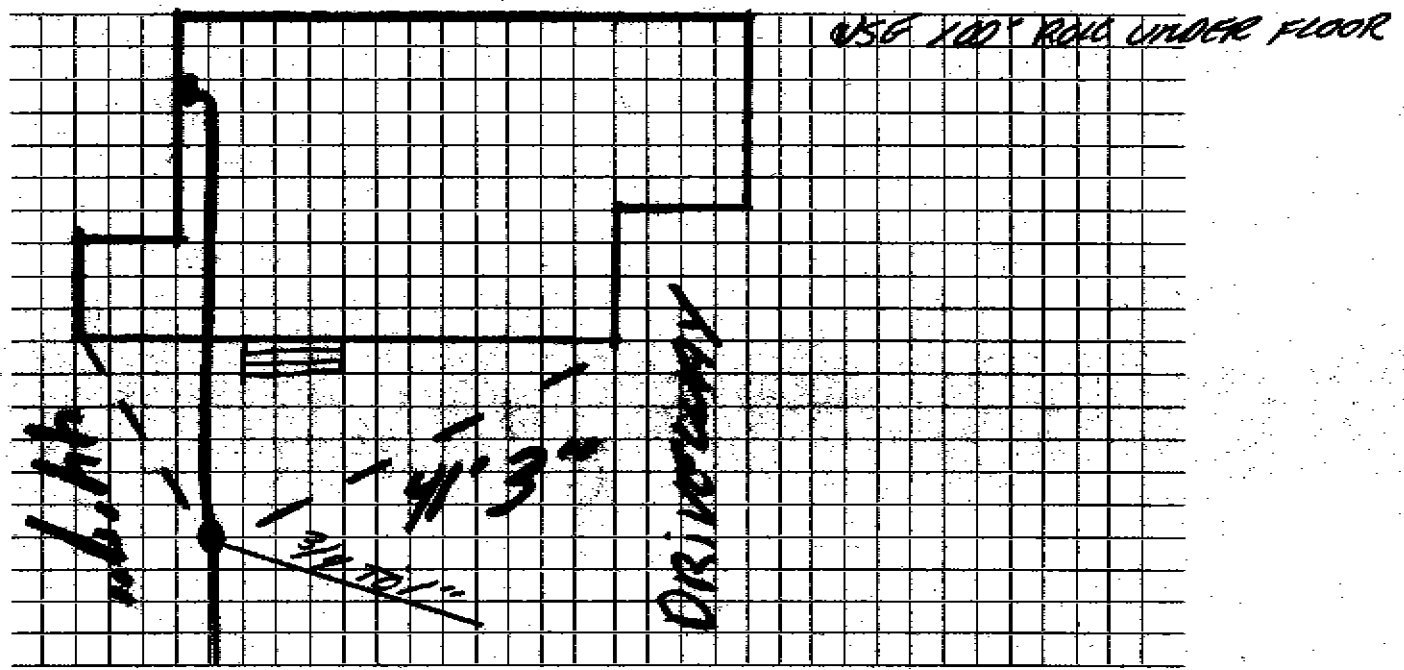

Connection made in 32 BRIDGE ST. Street.

Work completed

Remarks: