

Name Miss Alice Nelson  
 Address <sup>39</sup>~~150~~ Bridge Street

Service No. # 399  
 # 5261

Locatio Same

Kind of Pipe

Size

Size of Main

~~Repairs - Renewals~~ - New Service

Location

Date	Material	Amount	Total	Date	Amount
1935					
May 2	3 hrs. @ 55¢	1 65			
<i>10-05 Am. to Hessell 9/16/35</i>	3 " @ 60¢	1 80			
	10% Overhead on labor	35			
	35' 1" C.L. Pipe @ 20¢	7 00			
	2 1" L.L. Ells @ 30¢	60			
	2 1" L.L. Coup. @ 25¢	50			
	2 1" Brass Nipples @ 20¢	40			
	1 Stop & Waste	2 75			
	Trucking	1 00			
			16 05		
	Labor				
				1935	
				April 25	Cash (Deposited) 16 65
				July 16	Refunded 60
					16 05

Hadley Press, Inc., Lexington

37  
1935

DATE April 20, 1935

# TOWN OF LEXINGTON - BOARD OF PUBLIC WORKS

## WATER DIVISION

The undersigned applies for a supply of water at No. 457 Bridge St. St. and hereby agrees to comply with the rules and regulations as now, or at any future time, established by the Board of Selectmen.

Am't. of Estimate \$ 16.65

Owner

Miss Alice Nelson


Am't. Paid \$ \_\_\_\_\_

Address

Lucie Nelson  
85 Wendell St Camb.

Builder \_\_\_\_\_

Sketch of Service Here

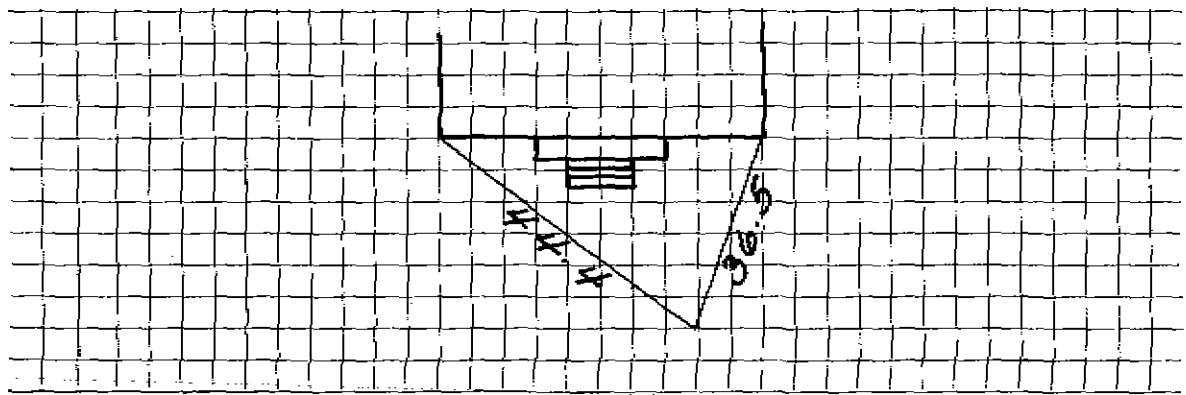

Connection made in \_\_\_\_\_ Street.

Work completed \_\_\_\_\_ 19

Remarks: