

WATER SERVICE RECORD

Name Robert. E. Johnson

Service No. 9

Address 40 Bridge Street

Location

~~Repair~~ - Renewal - ~~New Service~~ W.O. #6257

MAY 22 1978


Date	Material	Amount	Total	Date		Amount
5/4/78	Labor	18.19		5-5-78	Deposit	300.00
	10% O.H.	1.82	20.01	5-25-78	Refund	220.29
38'	3/4" Copper tubing @.83		31.54			79.71
1	3/4" Wheel Handle		17.10		OUTSIDE W.O. #6267	
1	3/4" X 1/2" Reducer		1.56	5-2-78	Labor	
				5-4-78		
1	hr. Trucking		3.00	29'	3/4" Copper tubing	
1	hr. Backhoe		6.50	1	3/4" Adapter	
			79.71	1	3/4" Curb	
				1	Box & Rod	
				2	ton Gravel	
				3	ton Cold Patch	
					Patch 3 x 28 Sidewalk	
					Patch 13 x 28 Street	

DATE _____

TOWN OF LEXINGTON — BOARD OF PUBLIC WORKS

WATER DIVISION

Sketch of Service Here
BRIDGE ST

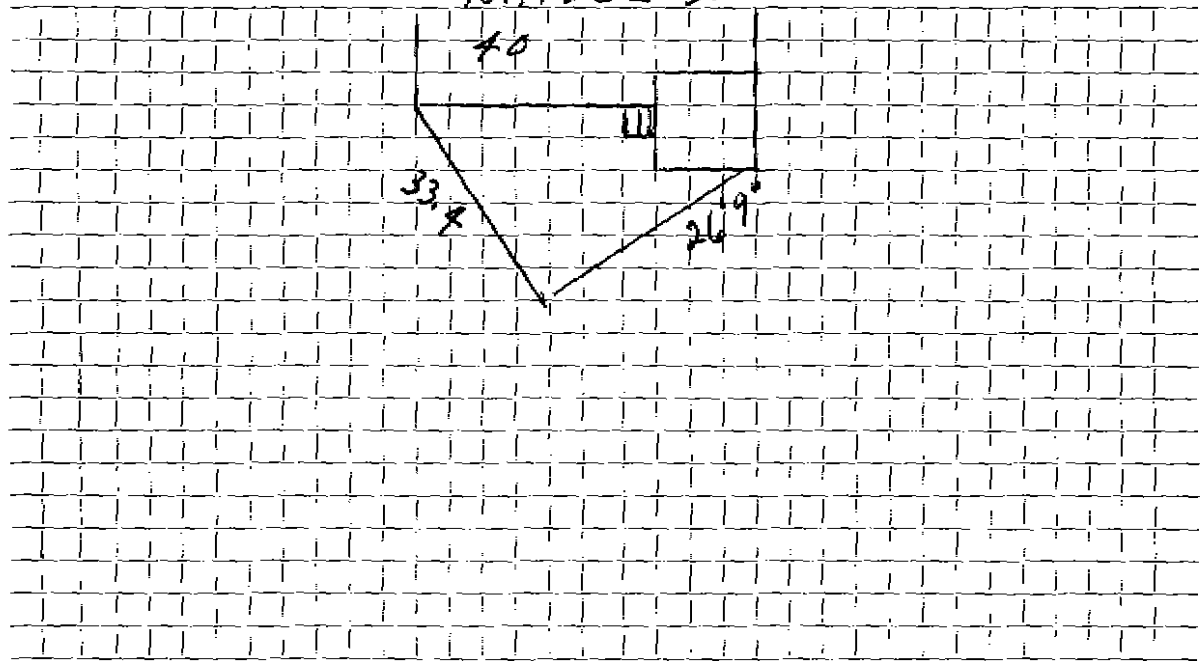

Connection made in Street. Work completed

Remarks:
.....
.....