

WATER SERVICE RECORD

Name Mt. Vernon Realty Trust

#2811 Service No. 52

Address 49 Bridge St.

Location Lexington

~~Repair/Rebuild~~ - New Service COM. 4-6-53


Date	Material	Amount	Total	Date	Amount
3/19/53	Labor	6 66		3-16-53 Deposited	50 -
	10% overhead	67	7 33	4-6-53 Refunded	(9 30
	43' 3/4" Copper Tubing @.34		14 62		40 70
	1-3/4" Cx 1/2" I.W.H. stop & waste		4 00	3/19/53 Labor	6 67
	2 Hrs. Littlefield Shovel @7.00		14 00	12' 3/4" Copper Tubing @.34	4 08
	1 Hr. Trucking		75	1-3/4" C. Corp-cock	4 33
			40 70	1-3/4" Cx 3/4" C. Curb-cock	4 67
				1-box & Rod	3 90
				1-1/2 Straight Tail Piece	50
				1-1/2 offset Tail Piece	50
				1 Hr. Littlefield Shovel	7 00
				1 Hr Trucking	75
					32 40

DATE _____

TOWN OF LEXINGTON — BOARD OF PUBLIC WORKS

WATER DIVISION

Sketch of Service Here

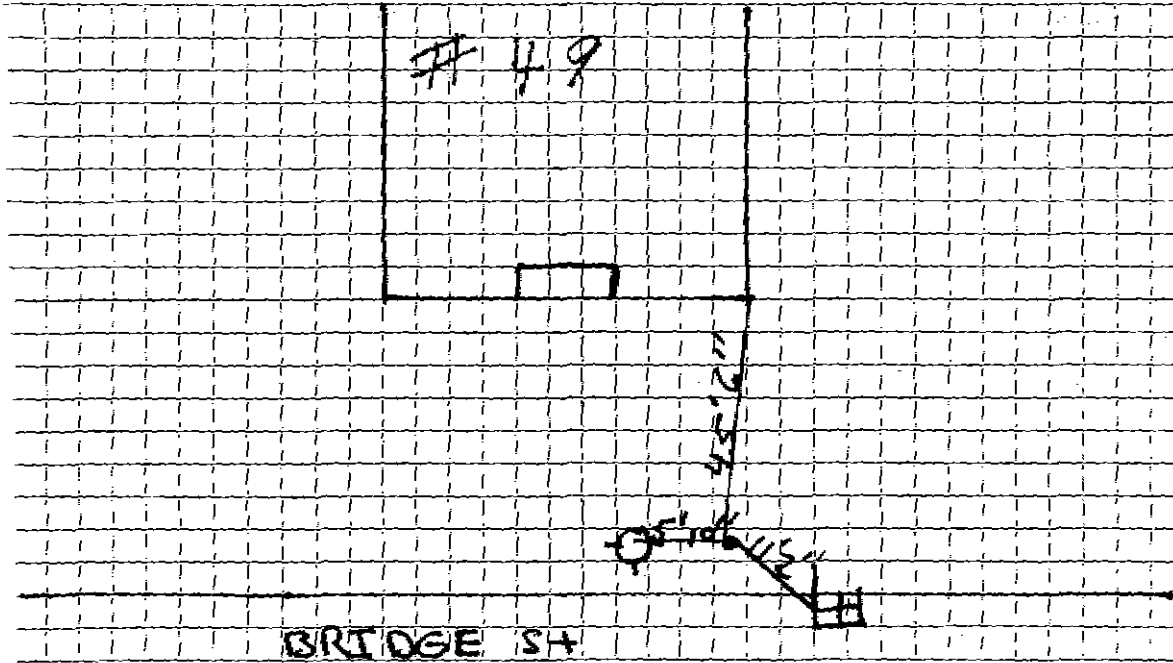

Connection made in Street. Work completed

Remarks:

.....

.....