

Name Stanley G. Spencer  
 Address 439 Waltham St., Lex.

Service No. ~~116~~ 402  
 #6226  
 #7073

Location 50 Bridge St.,

Kind of Pipe Size Size of Main  
 Repair—Renewal—New Service Location

Date	Material	Amount	Total	Date	Amount
1941					
Nov. 8,	6 hrs. @ 60¢		3 60	October 14, 1941	18 00
Com 7/24/41	10' Overhead		36	Dec 30, 1941	2 17
	38' 3/4" Copper tubing @ 19¢		7 22		13 43
	1 3/4" C.x 1/2" I.S. & W.		2 50		
	1 3/4" C. Union (3 parts)		1 00		
	1 hr. tracking @ 75¢		75		
			<u>15 43</u>		
	Labor				

Hadley Press, Inc., Lexington

DATE Sept 25, 1941

TOWN OF LEXINGTON—BOARD OF PUBLIC WORKS  
WATER DIVISION

The undersigned applies for a supply of water at No. 50 Bridge St. and hereby agrees to comply with the rules and regulations as now, or at any future time, established by the Board of Selectmen.

Am't. of Estimate \$ \_\_\_\_\_


Owner Stanley G. Spencer

Am't. Paid \$ \_\_\_\_\_

Address \_\_\_\_\_

Builder John Spencer  
#39 Hathorn St.

Sketch of Service Here

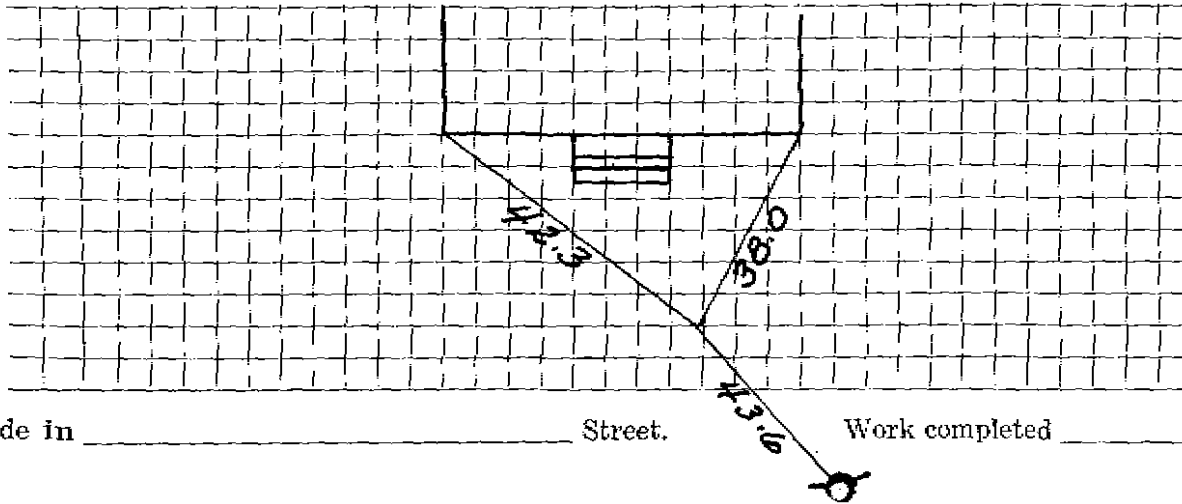

Connection made in \_\_\_\_\_ Street.

Work completed \_\_\_\_\_ 19

Remarks: