

WATER SERVICE RECORD

Name Mt. Vernon Realty Trust

Service No. 53

Address 51 Bridge Street

Location


~~Repair~~ ~~Renewal~~ New Service Com. 3/30/53

Date	Material	Amount	Total	Date	Amount
3/17/53	Labor	11 60		3-16-53	50 00
	10% Overhead	1 16	12 76	3-30-53	(2 17)
	48' - 3/4" Copper tubing @.34	16 32			NON CHARGE
	1 - 3/4" C x 1/2 I.W.H. stop & waste	4 00	3/16/53	Labor	14 38
	2 hrs. Littlefield shovel @.7	14 00		12' - 3/4" Copper tubing @.34	4 08
	1 hr. trucking		75	1 - 3/4" C. corp-cock	4 33
			47 83	1 - 3/4" C x 3/4" C. curb-cock	4 67
				1 box and rod	3 90
				1 - 1/2 straight tail piece	50
				1 - 1/2 offset tail piece	50
				2 hrs. Littlefield shovel @.7	14 00
				1 hr. trucking	75
					47 11

DATE \_\_\_\_\_

TOWN OF LEXINGTON — BOARD OF PUBLIC WORKS

**WATER DIVISION**

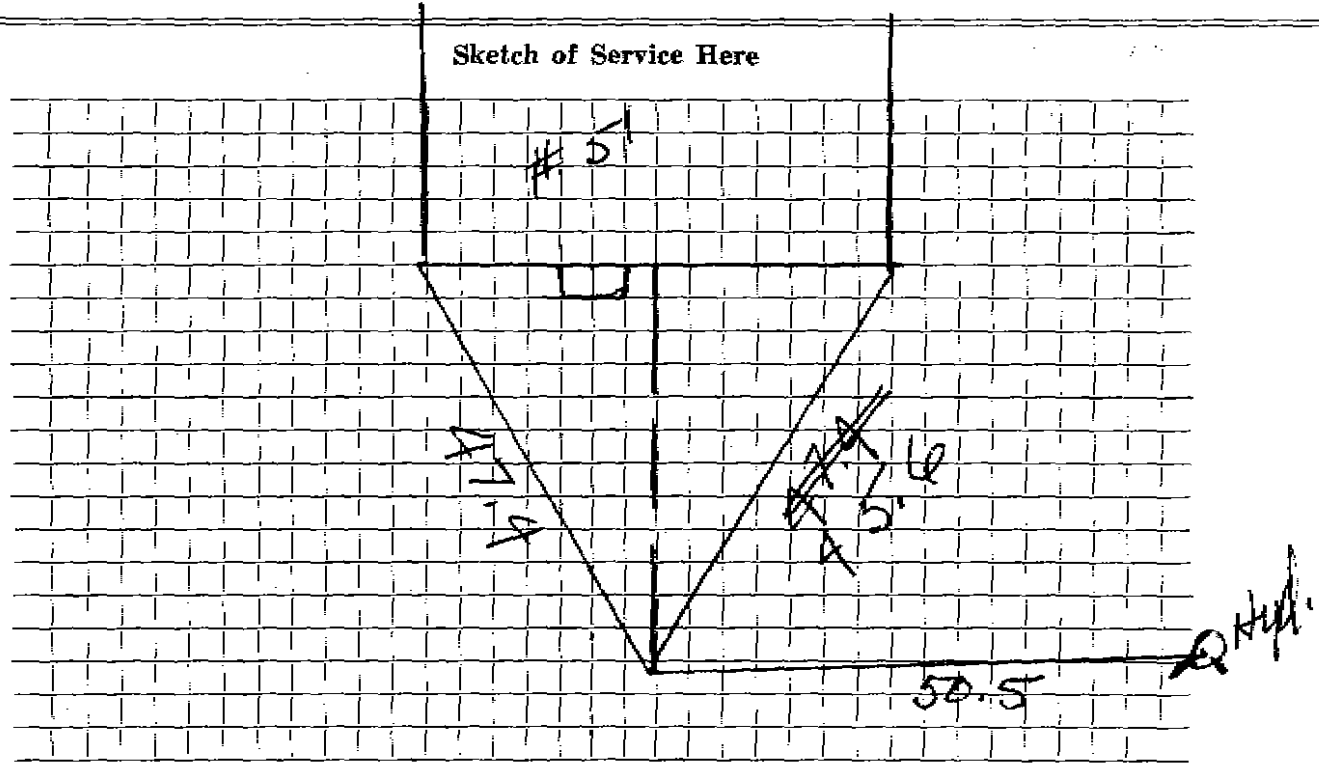

Connection made in ..... Street. Work completed .....

Remarks: .....

.....

.....