

Name Stanley Spencer
 Address 54 Bridge Street
 Easton, Mass.

Service No. 3347
 #2953
 #5070

Location 54 Bridge Street

Kind of Pipe

Size

Size of Main

~~Repair~~ ~~Renewal~~ New Service

Location

Date	Material	Amount	Total	Date	Amount
Aug. 22, '47	Labor	1 10	1 10	Aug 18 '47	10 00
	20% overhead		11	Apr 25 '47	2 17
	5' - 3/4" Copper Tubing @.28	1 40	1 40		7 83
	1 - 3/4" C x 1/2" I.W.K. S & W	3 15	3 15	Aug. 22, '47	18 67
	1 - 3/4" C x 3/4" C Union	3 pts 1 32	3 32	23	19 45
	Trucking 1 hr. @.75		75	28' - 3/4" Copper Tubing @.28	7 84
			7 83	1 - 3/4" C Corp-cock	3 00
				1 - 3/4" C x 3/4" C Curb-cock	3 68
				1 - Box & Rod	4 26
				1 - 1/2" Straight Tail Piece	30
				1 - 3/8" Offset Tail Piece	30
				Trucking 1 hr. @.75	75
					53 25

12/12 00
 BRUCE MAKE E
 2' - 3/4" C
 2 - 3/4" COMP UNIONS

3/4" Copper PITTED BAD
 New legs will locate
 Labor

Deposited
 Refunded
 Non-Charge

DATE _____

TOWN OF LEXINGTON - BOARD OF PUBLIC WORKS

WATER DIVISION

The undersigned applies for a supply of water at No..... St. and hereby agrees to comply with the rules and regulations as now, or at any future time, established by the Board of Selectmen.

Am't of Estimate \$.....

Owner


Am't Paid \$.....

Address *5 Bridge St*

Builder

.....

Sketch of Service Here

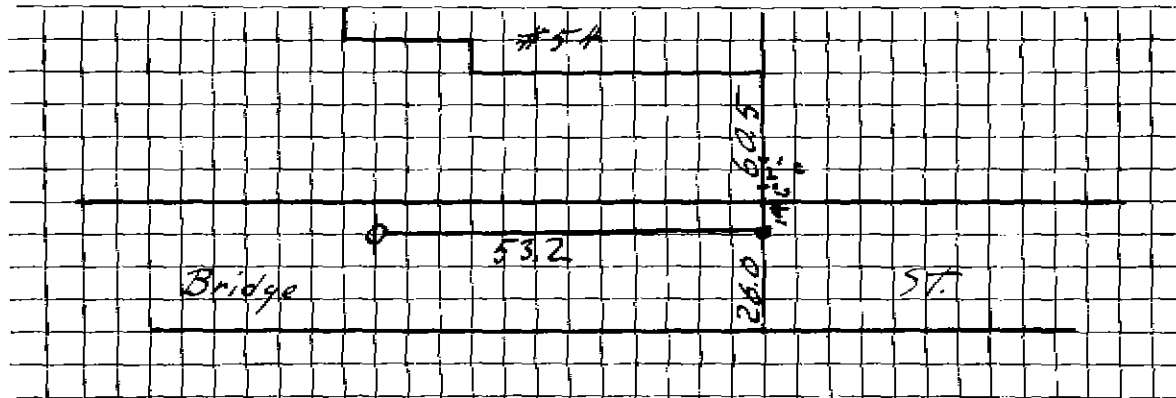

Connection made in^{1st} Street.

Work completed19

Remarks: *14.6" FROM CURB = UNION (3' C) = UNSICED*
COPPER IS PITTED bad MAY BE FROM ELECTRIC. Juice Running through COPPER