

WATER SERVICE RECORD

Service No. 179

Name Dominic Apruzzese

Address 55 Bridge Street

Location Lexington

~~Basic~~ ~~General~~ - New Service


Comm. 10-28-57

Date	Material	Amount	Total	Date	Amount
8/24/57		24 73		8-16-57	Deposit \$100 00
	10% overhead	2 47		10-28-57	Refund 31 21
			27 20		\$ 68 79
	43' 3/4" copper tubing @.375	16 13			NON CHARGE
	1 3/4" Cx 1/2" IWH st. & wste.	4 96		8/24	Labor 8 63
	1 hr. trucking		75		15' 3/4" copper tubing 3.75 5 63
	1 1/2 hr. town shovel @6.50		9 75		1 3/4" C. Corp Cock 5 94
	10 x 3 patch		10 00		1 3/4" C. Gurb Cock 4 64
			68 79		1 1/2 straight tailpiece 50
					1 1/2 offset tailpiece 50
					1/2 hr. town shovel @6.50 3 25
					29 09

TOWN OF LEXINGTON — BOARD OF PUBLIC WORKS
DATE _____

WATER DIVISION

Sketch of Service Here

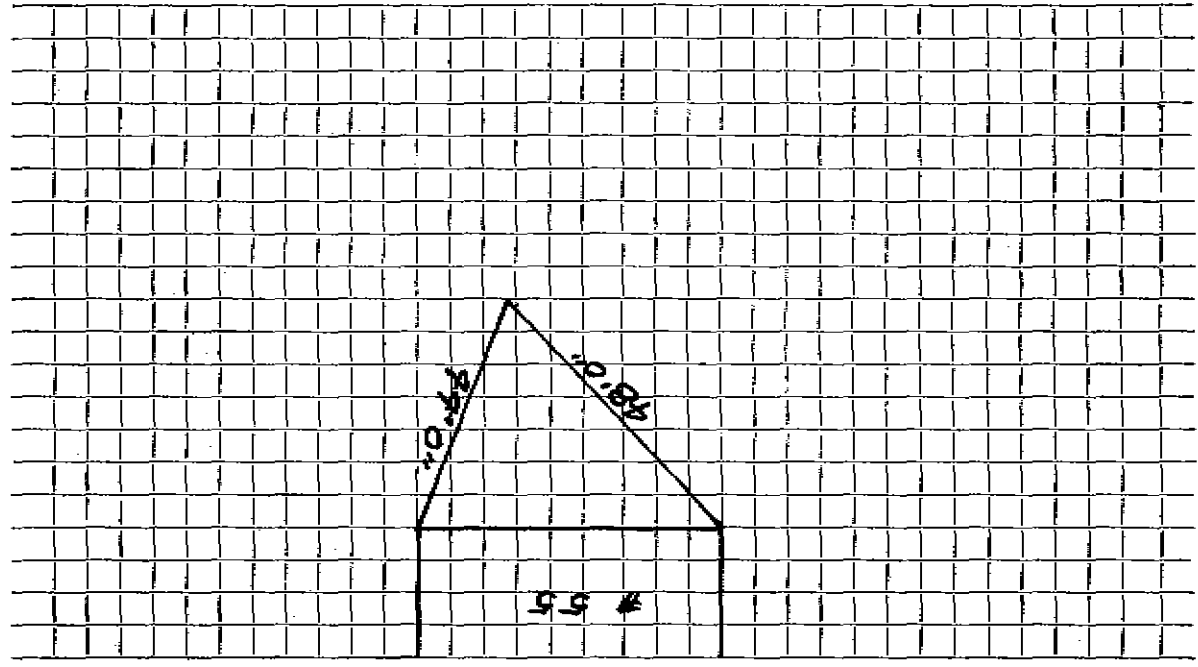

Connection made in _____ Street. Work completed _____

Remarks: _____