

WATER SERVICE RECORD

Name Robert Hayes

Service No. 234

Address 59 Bridge Street

#6930

Location

~~Repair~~ ~~Renewal~~ ~~New Service~~

Comm 3-16-59

Date	Material	Amount	Total	Date	Amount
11/26/58	Labor	3 89		11-21-58	Deposit 100 00
	10% overhead	39	4 28	3-16-59	Retund 62 89
	52' - 3/4" Copper tubing @ .37		19 24		<u>37 11</u>
	1 - 3/4" Cx 1/2 I.W.H. Stop & Waste		5 84		
	1 hr. Trucking		75		NON CHARGE
	7x3 Patch		7 00	11/26/58	Labor 23 07
			37 11		11' - 3/4" Copper tubing @ .37 14 07
					1 - 3/4" C. Corp Cock 4 64
					1 - 3/4" C. Curb Cock 6 03
					1 Box & Rod 5 00
					1 - 1/2" Straight tailpiece 50
					1 - 1/2" Offset tailpiece 50
					1 hr. Town Shovel 6 50
					<u>50 31</u>

DATE _____

TOWN OF LEXINGTON - BOARD OF PUBLIC WORKS

WATER DIVISION

The undersigned applies for a supply of water at No. _____ St. and hereby agrees to comply with the rules and regulations as now, or at any future time, established by the Board of Selectmen.


Am't. of Estimate \$ _____

Owner _____

Am't. Paid \$ _____

Address _____

Builder _____

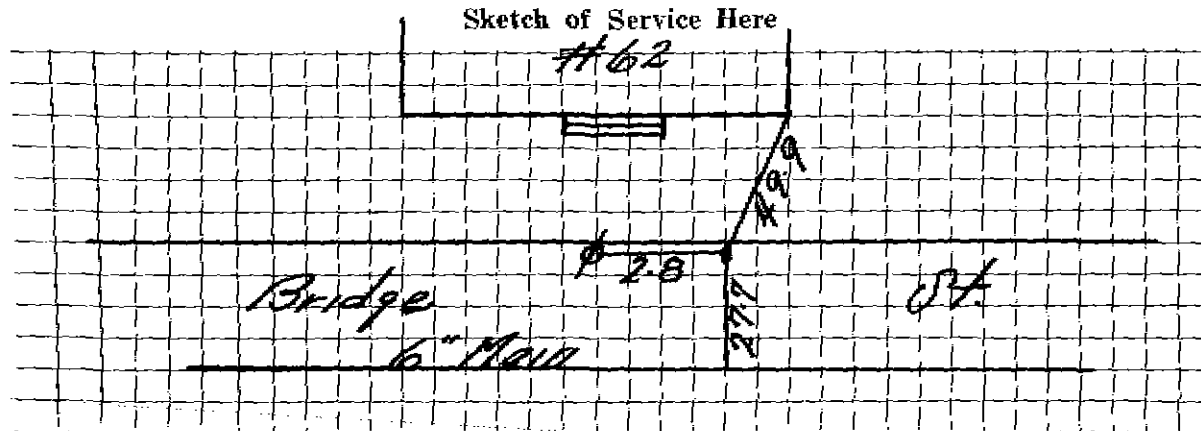

Connection made in _____ Street. Work completed _____ 19____

Remarks:

WATER SERVICE RECORD

Name Robert Hayes

Service No. 234

Address 59 Bridge Street

#6930

Location

~~Repair~~ ~~Renewal~~ ~~New Service~~


Chg. 3-16-59

Date	Material	Amount	Total	Date	Amount
11/26/58	Labor	3 89		11-21-58	Deposit 100 00
	10% overhead	39	4 28	3-16-59	Retard 62 89
	52' - 3/4" Copper tubing @ .37		19 24		37 11
	1 - 3/4" Cx 1/2 I.W.H. Stop & Waste		5 84		
	1 hr. Trucking		75		NON CHARGE
	7x3 Patch		7 00	11/26/58	Labor 23 07
			37 11	11' - 3/4" Copper tubing @ .37	14 07
				1 - 3/4" C. Corp Cock	4 64
				1 - 3/4" C. Curb Cock	6 03
				1 Box & Rod	5 00
				1 - 1/2 Straight tailpiece	50
				1 - 1/2 Offset tailpiece	50
				1 hr. Town Shovel	6 50
					50 31

DATE _____

TOWN OF LEXINGTON — BOARD OF PUBLIC WORKS
WATER DIVISION

Sketch of Service Here

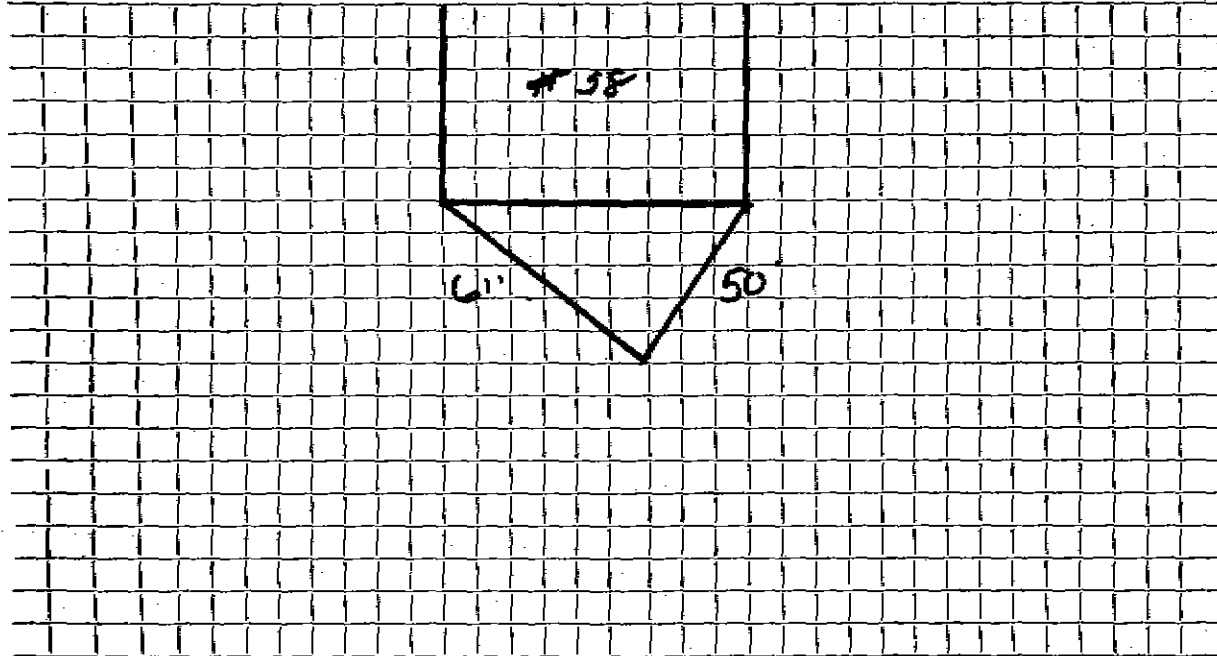

Connection made in Street. Work completed

Remarks:
.....
.....