

Name Henry Gamester
 Address 62 Bridge Street
 Lexington, Mass.

Service No. 52 3151

Location 62 Bridge Street

Kind of Pipe

Size

Size of Main

Repair—Renewal—New Service

Com. 9-23-46

Location

Date	Material	Amount	Total	Date	Amount
July 3, '46	Labor	90	90	June 29 '46	25 00
	10% Overhead		09	Oct 10 '46	9 93
	55' - 3/4" Copper Tubing @ .1911	10 51			15 07
	1-3/4" C x 1/2" I.W.H. Stop & Waste	2 82		July 2, '46	Labor 12 20
	Trucking 1 hr. @ .75		75	July 3, '46	Labor 18 14
			15 07	28' - 3/4" Copper Tubing @ .1911	5 35
				1 - 3/4" C. Corp-cock	3 98
				1 - 3/4" C. x 3/4" C. Curb-cock	3 30
				Trucking 1 hr.	75
				1 - 3/4" Offset Tail Piece	90
				1 - 3/4" Straight Tail Piece	90
				Trucking 1 hr.	75
	Labor				47 25

Deposited
Refunded
 Non-Charge

Hadley Press, Inc., Lexington

DATE _____

TOWN OF LEXINGTON — BOARD OF PUBLIC WORKS

WATER DIVISION

The undersigned applies for a supply of water at No. _____ St. and hereby agrees to comply with the rules and regulations as now, or at any future time, established by the Board of Selectmen.


Am't. of Estimate \$ _____

Owner _____

Am't. Paid \$ _____

Address _____

Builder _____

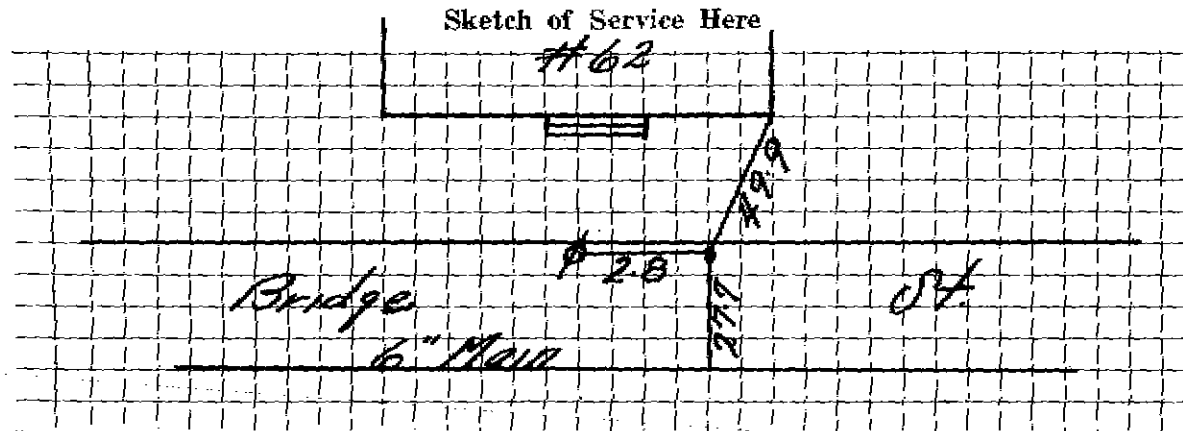

Connection made in _____ Street.

Work completed _____ 19__

Remarks: