

**WATER SERVICE RECORD**

Name

Service No.

Address 65 Bridge Street

Location

~~Repair~~—Renewal—New Service Main to Curb.


Date		Material	Amount		Total		Date	Amount
6/12/68		Labor	80	32				
6/14/68		"	18	14	98	46		
	11'	3/4" Copper @.79			8	69		
	1	3/4" Curb Cock			11	32		
	1	3/4" Adaptor			2	76		
	1/2	Ton Cold Patch @5.50			1	38		
	2	Hrs. Shovel @6.50			13	00		
	4	Hrs. Truck @3.00			12	00		
	1/2	Hrs. Roller @3.00			1	50		
		Trailer			2	00		
	1/2	Hr. Compressor @5.00			1	25		
					152	36		

DATE \_\_\_\_\_

TOWN OF LEXINGTON — BOARD OF PUBLIC WORKS

WATER DIVISION

Sketch of Service Here

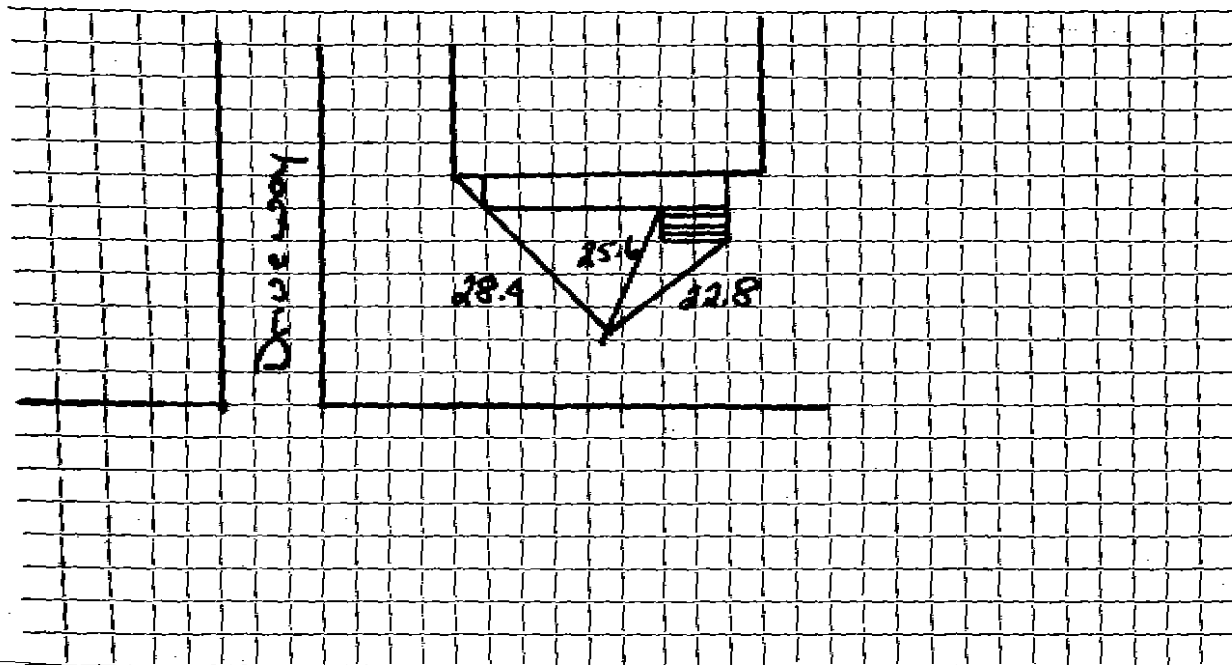

Connection made in ..... Street. Work completed .....

Remarks: .....

.....

.....