


DATE 2/6/96.

TOWN OF LEXINGTON — BOARD OF PUBLIC WORKS
WATER DIVISION

Sketch of Service Here

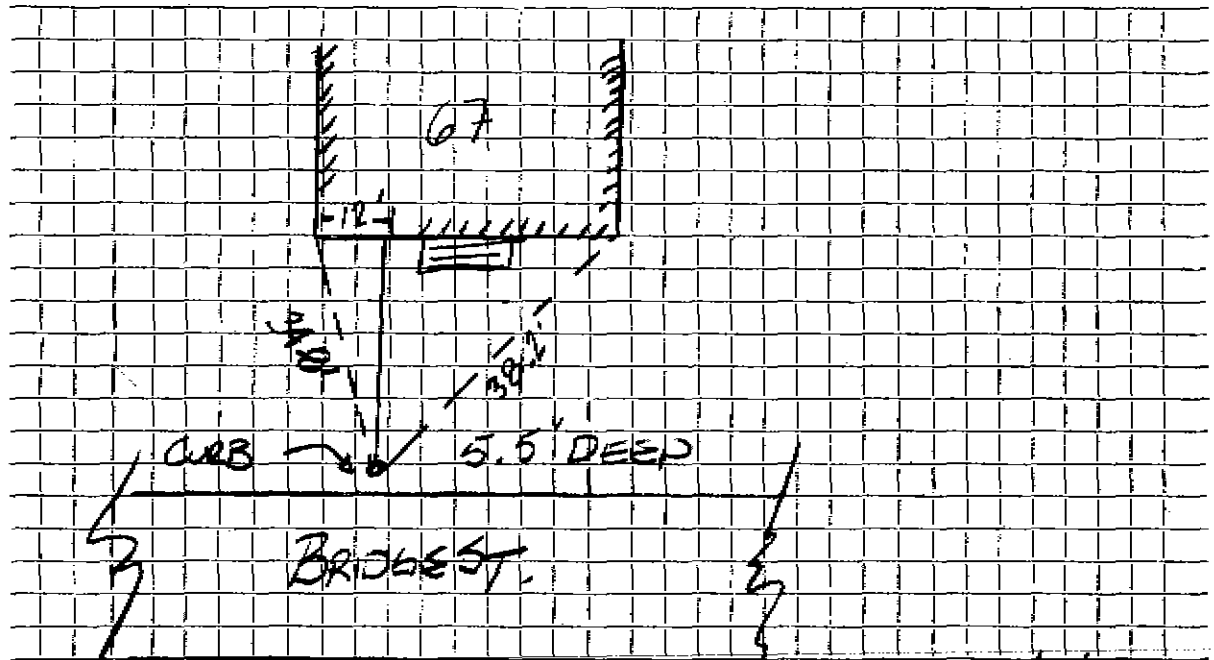

Connection made in 167 BRIDGEST Street. Work completed 2/6/95
Remarks: CONTRACTOR: PAUL ROSE
INSPECTED: TFH.